

9554

SURVEY & REMONUMENTATION

MAY 28 1997

COMMISSION

LAND CORNER RECORDATION CERTIFICATE
Filing Requirement of Act 74, Mich. P.A. 1970

Form with fields: For corners in Roscommon (County), Located In, Corner Code #. Includes numbered list 1-5 for survey details.

STATE OF MICHIGAN
ROSCOMMON COUNTY
RECORDED
23 DEC 96 9:47 A.M.
ROBERT V. SMITH
REGISTER OF DEEDS
Register of Deeds Stamp & File Number

Grid table with columns A-L and rows 1-13. Contains numerical data points for recording.

I, Marvin E. Myers, in a field survey on November 18, 1996, do hereby certify that under requirements of P.A. 74, Michigan P.A. of 1970, the corner points mentioned in lines 1 and 2 above were in conformance with regulations and rules therefore as required in the current manual of survey instructions of the United States Department of the Interior, Bureau of Land Management or by a decree of a Court of Law and/or that the corner points mentioned in lines 3, 4 and 5 above were in conformance with the rules of the Michigan Board of Professional Surveyors or by a Decree of a Court of Law; established, re-established, monumented, re-monumented, recovered, found as expressed below:

NOTE: Not more than 4 corners, all in the same town and range, may be recorded on this certificate.

A. Description of original monument and accessories and/or subsequent restoration:

Multiple columns of text describing survey monuments, bearings, distances, and references to previous surveys and plat maps.

B. Description of corner evidence found and/or method applied in restoring or reestablishing corner:


Found 1 1/2" x 30" Pipe in monument box one foot below monument box verified
WIT: SE Corner of E. GTE Box NW 69.1'
2.5' South of centerline of East - West centerline,
and is accepted as the best available evidence of the position of the Original Corner

C. Description of monument for corner and accessories established to perpetuate locating the position of the corner:

Placed standard Roscommon County monument in pav't box
WIT: Nail & tag in P.P. N31°E 551.32'
Nail & tag in P.P. N30°W 552.59'
Nail & tag in 4" R.Pine S32°W 399.75'
Nail & tag in 12" R.Pine S26°E 387'

ROSCOMMON COUNTY
PEER GROUP APPROVAL
DATE NOV 22 1996

Signature of Marvin E. Myers, P.S.
Marvin E. Myers, P.S.
County Surveyor

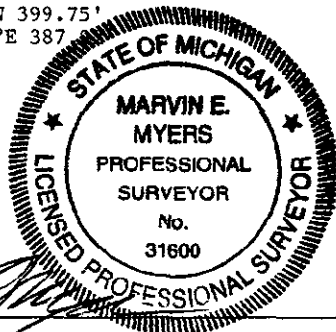

Signed by [Signature]
Surveyor's Michigan License No. 31600

Date DEC 17 1996

112-R-3 PAGE 215