

9262

ROSCOMMON COUNTY REMONUMENTATION

STATE OF MICHIGAN  
COUNTY OF ROSCOMMON

Dec 28 10 47 AM '93

FEB 16 1994

LAND CORNER RECORDATION CERTIFICATE  
Filing Requirement of Act 74, Mich. P.A. 1970

For corners in

Roscommon  
(County)

COMMISSION

Located In:

Corner Code #

- 1. Public Land Survey T 24 R 2 W K - 2  
T \_\_\_\_\_ R \_\_\_\_\_  
T \_\_\_\_\_ R \_\_\_\_\_  
T \_\_\_\_\_ R \_\_\_\_\_
- 2. Property Controlling S \_\_\_\_\_ T \_\_\_\_\_ R \_\_\_\_\_  
in Section S \_\_\_\_\_ T \_\_\_\_\_ R \_\_\_\_\_
- 3. Miscellaneous S \_\_\_\_\_ T \_\_\_\_\_ R \_\_\_\_\_  
Property in Sec. S \_\_\_\_\_ T \_\_\_\_\_ R \_\_\_\_\_

ROSCOMMON COUNTY  
PEER GROUP APPROVAL  
DATE 12-14-93

Register of Deeds Stamp & File Number

- 4. Lot No. \_\_\_\_\_, Recorded Plat \_\_\_\_\_
- 5. Private Claims \_\_\_\_\_

	A	B	C	D	E	F	G	H	I	J	K	L	M
2	6	5	4	3	2	1							
3													
4	7	8	9	10	11	12							
5													
6	18	17	16	15	14	13							
7													
8	19	20	21	22	23	24							
9													
10	30	29	28	27	26	25							
11													
12	31	32	33	34	35	36							
13													

I, Frank J. Arleth, in a field survey on December, 19 93, do hereby certify that under requirements of P.A. 74, Michigan P.A. of 1970, the corner points mentioned in lines 1 and 2 above were in conformance with regulations and rules therefore as required in the current manual of survey instructions of the United States Department of the Interior, Bureau of Land Management or by a decree of a Court of Law and/or that the corner points mentioned in lines 3, 4 and 5 above were in conformance with the rules of the Michigan Board of Land Surveyors or by a Decree of a Court of Law; established, re-established, monumented, re-monumented, recovered, found as expressed below:

NOTE: Not more than 4 corners, all in the same town and range, may be recorded on this certificate.

A. Description of original monument and accessories and/or subsequent restoration:


- William Burt Set Post 1852
- S. Pine 6" N34°W 30 Lks.
- S. Pine 8" S35°W 63 Lks.

B. Description of corner evidence found and/or method applied in restoring or reestablishing corner:

Henning 1946 Found 1/2" bar set by former survey on line & proper distance. All NBT's destroyed by R.C.R.C. road work, also corner destroyed. Arleth Land Survey Company witnessed corner before construction. Set 8' spikes at 90° to the East of section line at 50' and 100'. Of 3 witness used in 1986 by Arleth Land Survey Company only one that remains is 8" J. Pine S58°30"E 85.0'  
NOTE: in 1986 1/2" bar was found to be replaced with concrete mon for plat of DEERHEART WOODS as recorded 2/10/47.

C. Description of monument for corner and accessories established to perpetuate locating the position of the corner:

- Set Roscommon County Std. Mon stamped K - 2
- Nail & tag 16" J. Pine N50°W 68.38
- Nail & tag 10" J. Pine S82°E 43.90
- Nail & tag 8" B. Oak S59°W 73.70
- S.W. corner of Garage N64°E 84.31

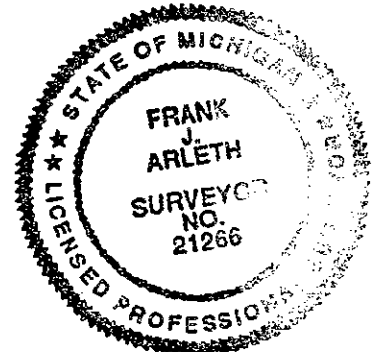

Signed by Frank J. Arleth

Date 21 DEC 93

Surveyor's Michigan License No. 21266

Date December 14, 1993

Peer Group Approved

LIBER 3 PAGE 88