

9261

ROSCOMMON COUNTY REMONUMENTATION

STATE OF MICHIGAN
COUNTY OF ROSCOMMON

LAND CORNER RECORDATION CERTIFICATE
Filing Requirement of Act 74, Mich. P.A. 1970

Dec 28 10 47 AM '93

FEB 18 1994

For corners in

Roscommon COMMISSION
(County)

Located In:

Corner Code #

- 1. Public Land Survey T 24 R 2 W K - 3
- T _____ R _____
- T _____ R _____
- T _____ R _____
- 2. Property Controlling S _____ T _____ R _____
- in Section S _____ T _____ R _____
- 3. Miscellaneous S _____ T _____ R _____
- Property in Sec. S _____ T _____ R _____

ROSCOMMON COUNTY
PEER GROUP APPROVAL
DATE 12-14-93

Register of Deeds Stamp & File Number

- 4. Lot No. _____, Recorded Plat _____
- 5. Private Claims _____

A	B	C	D	E	F	G	H	I	J	K	L	M
2	6	5	4	3	2	1						
3												
4	7	8	9	10	11	12						
5												
6	18	17	16	15	14	13						
7												
8	19	20	21	22	23	24						
9												
10	30	29	28	27	26	25						
11												
12	31	32	33	34	35	36						
13												

I, Frank J. Arleth, in a field survey on December, 19 93, do hereby certify that under requirements of P.A. 74, Michigan P.A. of 1970, the corner points mentioned in lines 1 and 2 above were in conformance with regulations and rules therefore as required in the current manual of survey instructions of the United States Department of the Interior, Bureau of Land Management or by a decree of a Court of Law and/or that the corner points mentioned in lines 3, 4 and 5 above were in conformance with the rules of the Michigan Board of Land Surveyors or by a Decree of a Court of Law; established, re-established, monumented, re-monumented, recovered, found as expressed below:

NOTE: Not more than 4 corners, all in the same town and range, may be recorded on this certificate.

A. Description of original monument and accessories and/or subsequent restoration:

- William Burt set post 1852
- Y. Pine 20" S48°W 73 Lks.
- Y. Pine 20" N65°E 102 Lks.

B. Description of corner evidence found and/or method applied in restoring or reestablishing corner:


Henning 1946 found orig. U. S. witness & 1/2" bar as set in corner by DelaMater. Year unknown, all witness destroyed.

NOTE: 1993 corners destroyed by R.C.R.C. in road construction. Concrete mon. was set at SW corner of section 1, T24N, R2W for corner of AuSable River Valley Subdivision(8/11/69) also destroyed in construction

Corner location witness by Arleth Land Survey Company prior to construction - 8" spikes set N88°52'E 100.0' and 8" spike set S88°52'W 50.0' from corner. Note R.C.R.C. set Mon Box in new Blacktop with 1/2" bar 33.0 North of true position.

C. Description of monument for corner and accessories established to perpetuate locating the position of the corner:

- Set Roscommon County Std. Mon. Stamped K- 3
- Nail & tag 14" N. Pine S50°W 104.22
- Nail & tag 12" W. Pine N23°E 114.48
- Nail & tag 8" N. Pine S47°E 116.44
- Nail & tag 12" J. Pine N50°W 62.05
- 1/2" bar in mon box 32.93 North
- Conc. Mon 33.00 West

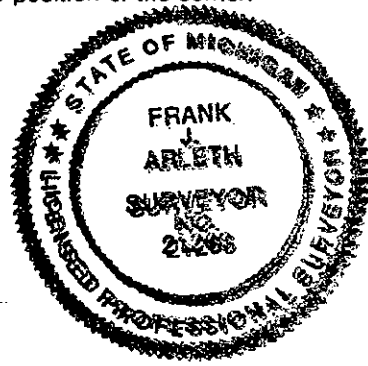

Signed by Frank J. Arleth Date 22 DEC 93

Surveyor's Michigan License No. 21266

Date December 14, 1993

Peer Group Approved