

4627

LAND CORNER RECORDATION CERTIFICATE
Filing Requirement of Act 74, Mich P.A. 1970

STATE OF MICHIGAN
ROSCOMMON COUNTY
RECORDED

11 JUL 97 4:12 P.M.

ROBERT W. SMITH
REGISTER OF DEEDS

For corners in
Roscommon County

Located in: Corner Code #

1. Public Land Survey

T23N	R 2W	K-1
T24N	R 2W	K-13
T	R	
T	R	

I, Larry L. Cavanagh, in a field survey June 20, 1997, do hereby certify that under requirements of P.A. 74, Michigan P.A. of 1970, the corner points mentioned in line 1 above was in conformance with regulations and rules therefore as required in the current manual of survey instructions of the United States Department of the Interior, Bureau of Land Management or by a decree of a Court of Law; established, re-established, monumented, recovered, found as expressed below:

Register of Deeds Stamp & File Number

	A	B	C	D	E	F	G	H	I	J	K	L	M
2	8		5		4		3		2		1		
3													
4	7		8		9		10		11		12		
5													
6	18		17		16		15		14		13		
7													
8	19		20		21		22		23		24		
9													
10	30		29		28		27		26		25		
11													
12	31		32		33		34		35		36		
13													

A. Description of original monument and accessories and/or subsequent restoration:

SET POST BY WILLIAM BURT, 1852
WIT: CEDAR 6 N20W 15
CEDAR 6 N54E 20

B. Description of corner evidence found and/or method applied in restoring or reestablishing corner:

NO ORIGINAL EVIDENCE FOUND. THIS CORNER SET BY SINGLE PROPORTIONATE DISTANCE BETWEEN I-1 AND L-1
K-1 TO I-1 S89°02'47"W 5288.87'
K-1 TO L-1 N89°02'47"E 2644.43'

C. Description of monument for corner and accessories established to perpetuate locating the position of the corner:

SET 3/4" PIPE WITH CAP INSIDE #17614 (IN SWAMP)
WIT: NAIL & TAG IN POWER POLE N23°W 153.36'
NAIL & TAG IN POWER POLE N60°E 294.20'
NAIL & TAG IN 3" MAPLE N38°E 238.60'
CARSONITE POST SOUTH 1.55'

A CAREFUL AND FAITHFUL ESTABLISHMENT OF THE POSITION OF THE CORNER.

SURVEY &
REMONUMENTATION

APR 07 1998


SECTION

ROSCOMMON COUNTY
PEER GROUP APPROVAL

DATE July 8, 1997

Marvin E. Myers

Marvin E. Myers, P.S.
County Surveyor

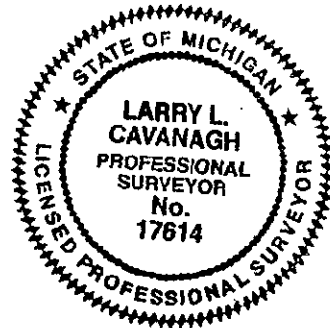

Signed by *Larry L. Cavanagh*
Surveyor's Michigan License No. 17614

Date July 9, 1997

FORM APPROVED BY MICHIGAN STATE BOARD OF LAND SURVEYORS, JAN 28, 1971
REVISED MAY 14, 1975
REVISED JAN., 1983

LIBER 3 PAGE 420