

LAND CORNER RECORDATION CERTIFICATE
Filing Requirement of Act 74, Mich. P.A. 1970

For corners in


<u>Roscommon</u> (County)	Located In:	Corner Code #
1. Public Land Survey	T _____ R _____	_____
2. Property Controlling In Section	S <u>2</u> T <u>24N</u> R <u>2W</u>	<u>6</u>
3. Miscellaneous Property in Sec.	S _____ T _____ R _____	<u>7</u>

4. Lot No. _____, Recorded Plat _____

5. Private Claims _____

I, Carl T. Kiiskila, in a field survey on June 29, 1998 do hereby state that under requirements of P.A. 74, Michigan P.A. of 1970, the corner points mentioned in lines 1 and 2 above were in conformance with regulations and rules therefore as required in the current manual of survey instructions of the United States Department of the Interior, Bureau of Land Management or by a decree of a Court of Law and/or that the corner points mentioned in lines 3, 4 and 5 above were in conformance with the rules of the Michigan Board of Land Surveyors or by a Decree of a Court of Law; established, re-established, monumented, recovered, found as expressed below:

NOTE: Not more than 2 corners, all in the same town and range, may be recorded on this certificate.

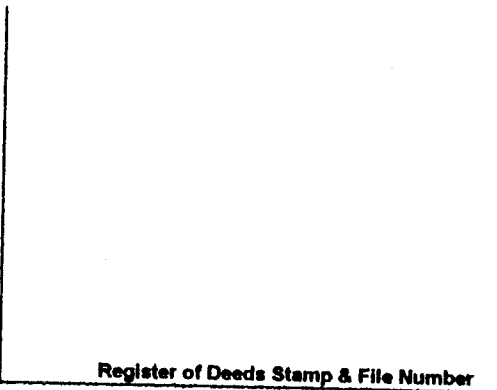

	A	B	C	D	E	F	G	H	I	J	K	L	M
1											●	●	
2	6		5		4		3		2			1	
3													
4	7		8		9		10		11		12		
5													
6	18		17		16		15		14		13		
7													
8	19		20		21		22		23		24		
9													
10	30		29		28		27		26		25		
11													
12	31		32		33		34		35		36		
13													

- A. Description of original monument and accessories and/or subsequent restoration:**
- 6 - This position was not established during the original government survey.
 - 7 - This position was not established during the original government survey.
- B. Description of corner evidence found and/or method applied in restoring or reestablishing corner:**
- 6 - Established the Northwest Corner of the Southeast Quarter of the Northeast Quarter of Section 2 per standard BLM instructions for subdivision of a section.
 - 7 - Established the Northeast Corner of the Southeast Quarter of the Northeast Quarter of Section 2 per standard BLM instructions for subdivision of a section. The pin falls in an existing monument box 3.5' west of the center of a north-south blacktop road.
- C. Description of monument for corner and accessories established to perpetuate locating the position of the corner:**
- 6 - Set 5/8" x 32" rerod with cap and set carsonite marker post.
 Witness: Set nail in 12" Jack Pine S 18° W 13.44'
 * Set nail in 5" Jack Pine S 34° E 22.79'
 Set nail in 5" Jack Pine S 76° E 14.56'
 Set nail in 6" Jack Pine N 05° W 16.16'
 - 7 - Set a 5/8" x 32" rerod with cap inside monument box.
 Witness: Set nail in 8" Jack Pine S 87° E 50.78'
 Set nail in 8" Jack Pine S 53° E 54.16'
 Set nail in 5" Jack Pine S 77° W 32.64'
 Center of north-south road East 3.5'
- * (old G.D. Henning witness)

Signed by Carl T. Kiiskila
 Surveyor's Michigan License No. 33981

Date 8-18-98

