ROSCOMMON CO. 72

Form 974.

T. 24 N R. 3 W Roscommon Co Mich.

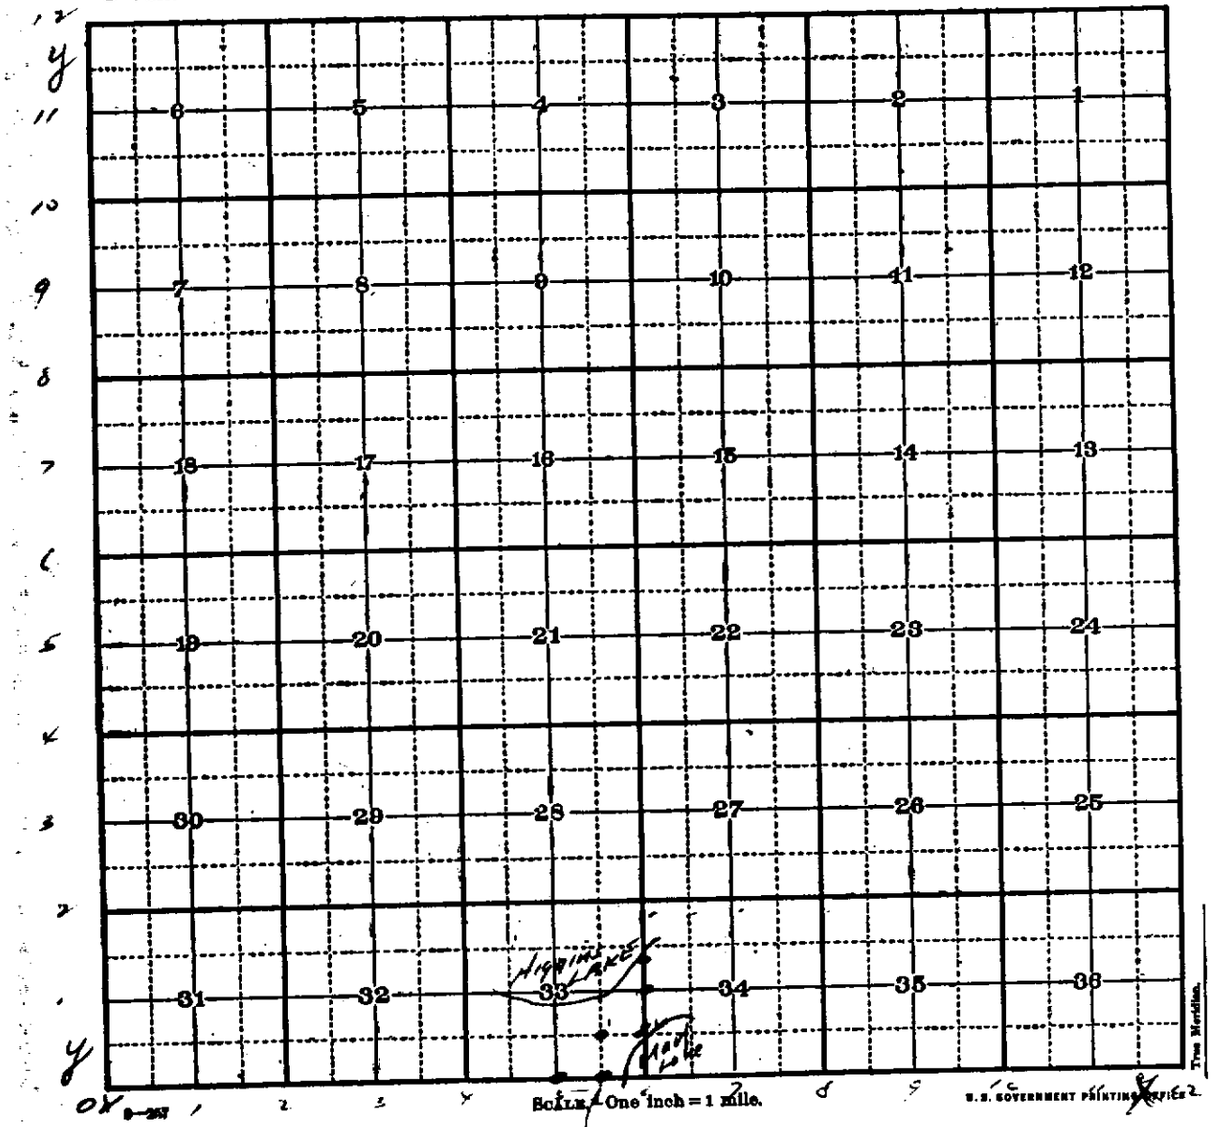

1/16 cor. set by C.M. CADE 1930