LAND CORNER RECORDATION CERTIFICATE

Filing Requirement of Act 74, Mich. P.A. 1970

For corners in ROSCOMMON (County)

	Located In:	Corner Code #1
1. Public Land Survey	T 24N R 3W	K-7, L-7
	T ___ R ___	
	T ___ R ___	
	T ___ R ___	
2. Property Controlling	S 13 T ___ R ___	15, 11
in Section	S ___ T ___ R ___	
3. Miscellaneous	S ___ T ___ R ___	
Property in Sec.	S ___ T ___ R ___	

Register of Deeds Stamp & File Number

4. Lot No. _____ , Recorded Plat _____
5. Private Claims _____

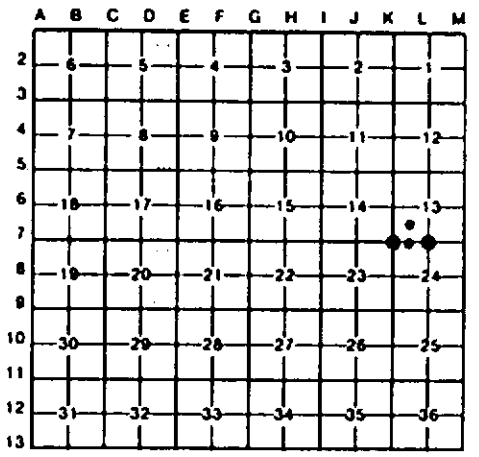

I, CARL F. ROSER, in a field survey on MAY, 31, 19 95, do hereby certify that under requirements of P.A. 74, Michigan P.A. of 1970, the corner points mentioned in lines 1 and 2 above were in conformance with regulations and rules therefore as required in the current manual of survey instructions of the United States Department of the Interior, Bureau of Land Management or by a decree of a Court of Law and/or that the corner points mentioned in lines 3, 4 and 5 above were in conformance with the rules of the Michigan Board of Land Surveyors or by a Decree of a Court of Law; established, re-established, monumented, re-monumented, recovered, found as expressed below:

NOTE: Not more than 4 corners, all in the same town and range, may be recorded on this certificate.

A. Description of original monument and accessories and/or subsequent restoration:

K-7 L-7 15 11

(NO EVIDENCE OF G.L.O. CORNER, B.T'S, LINE TREES & TOPOGRAPHY, AS CALLED OUT IN THE G.L.O. LINE NOTES; UNLESS NOTED IN ITEM "B" BELOW.)

STATE OF MICHIGAN
CARL F. ROSER
LAND SURVEYOR
No. 12028
REGISTERED LAND SURVEYOR

B. Description of corner evidence found and/or method applied in restoring or reestablishing corner:

K-7	L-7	15	11
FD IRON ROD IN MON. BOX FOR SW COR. S-13. CORNER FITS PREVIOUS SURVEYS OF RECORD IN SEC'S 13 AND 14.	FD REROD IN MON BOX IN CTR OF ROAD, FOR S1/4 COR OF S-13. CORNER FITS PROPORTIONATE POSITION TO US GLO RUN OUT MEAS. ON S. LINE S-13.	FD REROD IN MON BOX FOR SE COR OF W1/2 OF SW1/4 S-13.	ESTABLISHED THE CENTER OF SW1/4 OF SEC. 13 PER STANDARD BLM INSTRUCTIONS.

C. Description of monument for corner and accessories established to perpetuate locating the position of the corner:

K-7			L-7			15			11		
FD 3/4" IRON ROD IN MON BOX.			FD 5/8" REROD IN MON BOX.			FD 5/8" REROD IN MON BOX IN B.TOP RD INTER (E-W-N).			SET 5/8"x 17" CAPPED REROD.		
FN COR POST	S41°E	44.67'	5" J.PINE	NORTH	41.35'	POWER POLE	S30°E	36.52'	UTILITY POLE	S47°W	38.78'
FN COR POST	S44°W	43.35'	5" J.PINE	N31°E	50.35'	6" J.PINE	N40°E	80.96'	9" R. PINE	N48°W	46.89'
UTILITY POLE	N64°W	79.58'	#6" J.PINE	S03°W	51.88'	STREET SIGN	N48°W	54.54'	4" W.PINE	N47°E	59.22'
24" R.PINE	N34°E	83.20'	#16" OAK	S45°W	70.20'				7" ASPEN	S85°E	41.10'
			DROVE 5/8"x 18" REROD W/PS CAP	N85°57'44"E	662.12'				CTR. OF RD.	EAST	8'

1= OLD WIT.

Signed by Carl F. Roser Date 6-26-95

Surveyor's Michigan License No. 12028

FORM APPROVED BY MICHIGAN STATE BOARD OF LAND SURVEYORS, JAN. 28, 1971
REVISED MAY 14, 1975
REVISED JAN., 1983