LAND CORNER RECORDATION CERTIFICATE

Filing Requirement of Act 74, Mich. P.A. 1970

For corners in ROSCOMMON (County)

	Located In:	Corner Code #1
1. Public Land Survey	T 24N R 3W	K-5
	T ___ R ___	
	T ___ R ___	
	T ___ R ___	
2. Property Controlling	S 13 T ___ R ___	1, 4
in Section	S ___ T ___ R ___	
3. Miscellaneous	S ___ T ___ R ___	
Property in Sec.	S ___ T ___ R ___	

Register of Deeds Stamp & File Number

4. Lot No. _____ , Recorded Plat _____
5. Private Claims _____

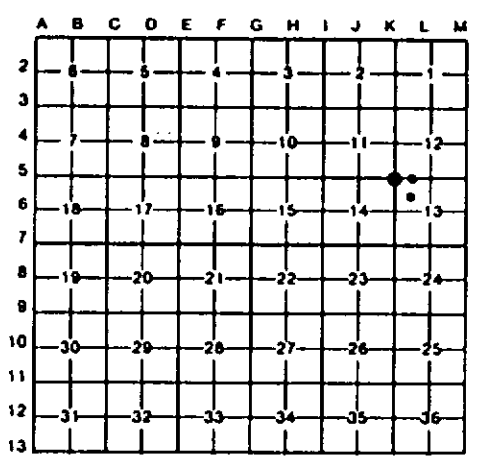

I, C.F. ROSER, in a field survey on MAY, 31, 19 95, do hereby certify that under requirements of P.A. 74, Michigan P.A. of 1970, the corner points mentioned in lines 1 and 2 above were in conformance with regulations and rules therefore as required in the current manual of survey instructions of the United States Department of the Interior, Bureau of Land Management or by a decree of a Court of Law and/or that the corner points mentioned in lines 3, 4 and 5 above were in conformance with the rules of the Michigan Board of Land Surveyors or by a Decree of a Court of Law; established, re-established, monumented, re-monumented, recovered, found as expressed below:

NOTE: Not more than 4 corners, all in the same town and range, may be recorded on this certificate.

A. Description of original monument and accessories and/or subsequent restoration:

K-5 1 4

(NO EVIDENCE OF G.L.O. CORNER, B.T'S, LINE TREES & TOPOGRAPHY, AS CALLED OUT IN THE G.L.O. LINE NOTES; UNLESS NOTED IN ITEM "B" BELOW.)

B. Description of corner evidence found and/or method applied in restoring or reestablishing corner:

K-5

FOUND IRON BAR IN CTR OF COUNTY ROAD FOR NW COR S-13. CORNER FITS SURVEYS IN SEC. 13 AND 14 BY C.E.OSTLING, PS#12026 AND R.T.OSTLING, PS#5133.

1

FD PIPE FOR NW COR OF NE1/4 OF NW1/4 OF SEC 13. CTR. OF B.TOP ROAD LOOKING SOUTH IS 4' EAST (COR IS NE OF B.TOP RD IN CURVE, ROAD SOUTH AND WEST).

4

FD IRON ROD FOR CTR. OF NW1/4 OF S-13. COR FITS CERT. OF SURVEY BY G.HENNING, PS #2240 IN THE SW1/4 OF NE1/4 OF NW1/4. FD ROW IRONS 33.13' EAST, #2240 AND 32.98' WEST, #12026. EDGE OF PAVEMENT IS WEST 6.7'.

C. Description of monument for corner and accessories established to perpetuate locating the position of the corner:

K-5

FD. 1 1/4" IRON BAR IN CTR OF COUNTY RD (4" DEEP).

14" J.PINE	N31°W	27.37'
#16" J.PINE	N56°E	31.18'
14" OAK	S58°E	35.68'
UTILITY POLE	S30°W	67.41'
CEDAR POST	NORTH	25'

#= C.E.OSTLING WIT.

1

FD. 1" PINCH PIPE, SET CEDAR POST.

#TW. OAK	N53°W	82.33'
#9" OAK	S63°E	75.72'
#16" OAK	N79°W	81.86'
POWER POLE	S20°E	80.70'

S'LY I-75 ROW FN IS NORTH 56'

DROVE 5/8"X' REROD S00°53'55"W 663.88'

#= MDOT WIT.

4

FD 1/2" IRON ROD IN B.TOP.

19" J.PINE	N87°E	34.65'
POWER POLE	N34°E	66.75'
11" W.PINE	S54°E	56.25'
TELE. POLE	S58°W	35.57'
SET POST	EAST	33'

FD 1/2" REROD W/PS CAP #2240 N85°01'27"E 664.45'

DROVE 5/8"x 32" REROD W/PS CAP S00°53'09"W 664.15'

STATE OF MICHIGAN — CARL F. ROSER — LAND SURVEYOR — No. 12028 — REGISTERED LAND SURVEYOR

Signed by Carl F. Roser Date 6-26-95

Surveyor's Michigan License No. 12028

FORM APPROVED BY MICHIGAN STATE BOARD OF LAND SURVEYORS, JAN. 28, 1971
REVISED MAY 14, 1975
REVISED JAN., 1983