LAND CORNER RECORDATION CERTIFICATE

Filing Requirement of Act 74, Mich. P.A. 1970

For corners in ROSCOMMON (County)

	Located In:	Corner Code ##
1. Public Land Survey	T 24N R 3W	K-6, L-6
	T ___ R ___	
	T ___ R ___	
	T ___ R ___	
2. Property Controlling	S 13 T ___ R ___	13
in Section	S ___ T ___ R ___	
3. Miscellaneous	S ___ T ___ R ___	
Property in Sec.	S ___ T ___ R ___	

Register of Deeds Stamp & File Number

4. Lot No. _____ , Recorded Plat _____
5. Private Claims _____

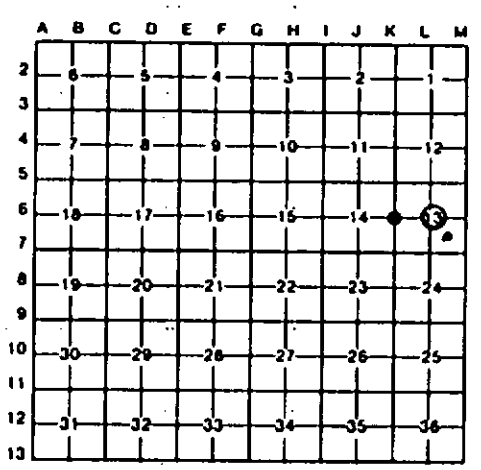

I, CARL F. ROSER , in a field survey on MAY, 31 , 19 95 , do hereby certify that under requirements of P.A. 74, Michigan P.A. of 1970, the corner points mentioned in lines 1 and 2 above were in conformance with regulations and rules therefore as required in the current manual of survey instructions of the United States Department of the Interior, Bureau of Land Management or by a decree of a Court of Law and/or that the corner points mentioned in lines 3, 4 and 5 above were in conformance with the rules of the Michigan Board of Land Surveyors or by a Decree of a Court of Law; established, re-established, monumented, re-monumented, recovered, found as expressed below:

NOTE: Not more than 4 corners, all in the same town and range, may be recorded on this certificate.

A. Description of original monument and accessories and/or subsequent restoration:

K-6 L-6 13

(NO EVIDENCE OF G.L.O. CORNER, B.T'S, LINE TREES & TOPOGRAPHY, AS CALLED OUT IN THE G.L.O. LINE NOTES; UNLESS NOTED IN ITEM "B" BELOW.)

B. Description of corner evidence found and/or method applied in restoring or reestablishing corner:

K-6
FD 1/2" IRON ROD FOR W1/4 COR S-13. CORNER FITS SURVEYS IN SEC. 13 & 14 BY VARIOUS PRIVATE SURVEYORS.

L-6
FD IRON W/PS F.J.ARLETH CAP FOR CENTER OF S-13. COR FITS PROPER SUB'D OF SEC. 13 AND OTHER SURVEYS OF RECORD IN S-13. CORNER IS IN LINE WITH FENCE TO WEST.

13
ESTABLISHED THE CTR. OF SE1/4 OF SEC. 13 PER STANDARD BLM INSTRUCTIONS.

C. Description of monument for corner and accessories established to perpetuate locating the position of the corner:

K-6
FD 1/2" IRON ROD, SET CEDAR POST.

16" MAPLE	N02°W	40.26'
5" W.PINE	N61°E	26.93'
6" W.PINE	S67°E	11.11'
6" W.PINE	N70°W	3.76'

FN COR POST (FN N & W)

IS	S54°E	29.9'

L-6
FOUND 1/2" SMOOTH IRON W/PS CAP, SET CEDAR POST.

10" J.PINE	N50°W	3.73'
8" W.OAK	N12°E	26.53'
8" B.OAK	N86°E	10.88'
8" W.OAK	S26°W	35.90'

OLD N-S FN REMAINS EAST 13'±

13
SET 5/8"x 32" REROD W/PS CAP & CEDAR POST.

6" J.PINE	N15°W	13.28'
10" J.PINE	S39°E	12.57'

SET 5/8"x 32" REROD W/PS CAP N85°37'53"E 500.00'

SET 5/8"x 32" REROD W/PS CAP & SET CEDAR POST S85°38'32"W 662.75'

STATE OF MICHIGAN
CARL F. ROSER
LAND SURVEYOR
No. 12028
REGISTERED LAND SURVEYOR

Signed by Carl F. Roser Date 6-26-95

Surveyor's Michigan License No. 12028

FORM APPROVED BY MICHIGAN STATE BOARD OF LAND SURVEYORS, JAN. 28, 1971
REVISED MAY 14, 1975
REVISED JAN., 1983