

LAND CORNER RECORDATION CERTIFICATE
Filing Requirement of Act 74, Mich. P.A. 1970

MAY 28 1997

COMMISSION

For corners in Roscommon (County)

Located In:

Corner Code #

- 1. Public Land Survey T 24N R 3W C - 1
2. Property Controlling in Section S T R
3. Miscellaneous Property in Section S T R

STATE OF MICHIGAN ROSCOMMON COUNTY RECORDED 23 DEC 96 9:47 A.M. ROBERT W. SMITH REGISTER OF DEEDS Register of Deeds Stamp & File Number

4. Lot No. Recorded Plat
5. Private Claims

Grid table with columns A-M and rows 1-13. A dot is marked in cell C-2.

I, Marvin E. Myers, in a field survey on November, 19 96, do hereby certify that under requirements of P.A. 74, Michigan P.A. of 1970, the corner points mentioned in lines 1 and 2 above were in conformance with regulations and rules therefore as required in the current manual of survey instructions of the United States Department of the Interior, Bureau of Land Management or by a decree of a Court of Law and/or that the corner points mentioned in lines 3, 4 and 5 above were in conformance with the rules of the Michigan Board of Professional Surveyors or by a Decree of a Court of Law; established, re-established, monumented, re-monumented, recovered, found as expressed below:

NOTE: Not more than 4 corners, all in the same town and range, may be recorded on this certificate.

A. Description of original monument and accessories and/or subsequent restoration:

- GLO John Brink 1839 Mon.-Set Post WIT: 7" W.Oak N10°E 15 lks. 10" W.Oak N39°W 50 lks.
G.D. Henning Oct. 1976 L.156, pg.279 Mon.-Fd. 1/2" Bar WIT: 12" W.Oak N30°E 79.0' 3" Y.Pine N30°E 102.2' Conc. mon. 33.0' North
G.F. Delmater Sept. 23, 1939 Mon.-Woodstake over 1/2" bar WIT: 16" B.Oak N15°W 63.3' 6" B.Oak S45°W 42.3' 7" W.Oak S60°E 73.1'
L.3 pg.173 M.E. Myers Dec. 1994 Mon.-Std. Crawford County Mon. WIT: Fd. conc. mon. N07°E 32.90' Fd. tag & nail N. side 15" W.Oak S55°E 76.8' Fd. tag & nail SE side 11" B.Oak S45°W 64.29' Fd. tag & nail NE side 9" R.Pine N35°W 67.81' Fd. blaze S. face 17" B.Oak N15°W 63.25' Fd. tag & nail SE side 16" W.Oak N47°E 79.56' Fd. 13" W.Oak S52°E 73.00'

B. Description of corner evidence found and/or method applied in restoring or reestablishing corner:


Found Crawford County monument in mon. box and accessories recorded in Liber 3, page 172, Crawford County Records And is accepted as the best available evidence of the position of the Original Corner.

C. Description of monument for corner and accessories established to perpetuate locating the position of the corner:

- Mon.-Std. Crawford County Mon. in pav't box
WIT: Fd. conc. mon. N07°E 32.90'
Fd. tag & nail N. side 15" W.Oak S55°E 76.8'
Fd. tag & nail SE side 11" B.Oak S45°W 64.29'
Fd. tag & nail NE side 9" R.Pine N35°W 67.81'
Fd. blaze S. face 17" B.Oak N15°W 63.25'
Fd. tag & nail SE side 16" W.Oak N47°E 79.56'
Fd. 13" W.Oak S52°E 73.00'

ROSCOMMON COUNTY PEER GROUP APPROVAL DATE NOV 8th 1996

Marvin E. Myers, P.S. County Surveyor

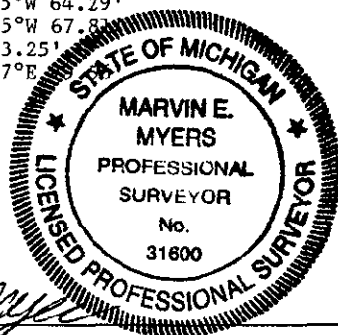

Signed by Marvin E. Myers Surveyor's Michigan License No. 31600

Date DEC 14, 1996

112-3 DATE 3.12