

MAY 28 1997

9563

COMMISSION

LAND CORNER RECORDATION CERTIFICATE
Filing Requirement of Act 74, Mich. P.A. 1970

Form with fields: For corners in Roscommon (County), Located In, Corner Code #, 1. Public Land Survey, 2. Property Controlling in Section, 3. Miscellaneous Property in Section, 4. Lot No., 5. Private Claims

STATE OF MICHIGAN
ROSCOMMON COUNTY
RECORDED

23 DEC 96 9:49 A.M.

ROBERT W. SMITH
REGISTER OF DEEDS

Register of Deeds Stamp & File Number

I, Marvin E. Myers, P.S.; in a field survey on Nov, 1996, do hereby certify that under requirements of P.A. 74, Michigan P.A. of 1970, the corner points mentioned in lines 1 and 2 above were in conformance with regulations and rules therefore as required in the current manual of survey instructions of the United States Department of the Interior, Bureau of Land Management or by a decree of a Court of Law and/or that the corner points mentioned in lines 3, 4 and 5 above were in conformance with the rules of the Michigan Board of Professional Surveyors or by a Decree of a Court of Law; established, re-established, monumented, re-monumented, recovered, found as expressed below:

NOTE: Not more than 4 corners, all in the same town and range, may be recorded on this certificate.

A. Description of original monument and accessories and/or subsequent restoration:
GLO 1852 W. Burt Nov. 10, 1949 G.D. Henning
Mon.-Unknown

Sept. 22, 1939 G.F. Delamater
Mon.-several conc. monuments
were placed on section line
one marked as "m.p."

WIT: Report indicates Houghton
marked this line in 1925
A concrete monument was
found near the Lake shore
which measured 3765.3'

R.T. Ostling
Mon.-Conc. mon.
WIT: N02°42'E 3666.3 NW
corner Section

Grid table with columns A-M and rows 2-13, containing numbers 1-36 and a dot in cell C2.

B. Description of corner evidence found and/or method applied in restoring or reestablishing corner:

Found concrete monument (found several bars and concrete monuments along the section line between the Northwest corner of Section 5 and the West 1/2 corner corner) verified by measurement to the NW corner of Section 5 N02°42'E 3666.3 recorded, 3665.95 measured. This corner was not set at during the original GLO field survey and a note was entered in the original notes. A meander corner was set and this corner location was apparently established by protraction from the GLO plat. It is unclear from reviewing subsequent survey data who monumented the position. By reviewing subsequent surveys which perpetuated the meander corner this monument is monument is accepted as a careful and faithful determination of the position of the corner.

C. Description of monument for corner and accessories established to perpetuate locating the position of the corner:


Set Roscommon County monuemnt
WIT: Nail & tag in 12" W.Pine N78°E 29.47'
Nail & tag in 28" R.Oak N16°W 19.69'
Nail & tag in 12" R.Oak S82°W 11.38'
Nail & tag in 20" W.Pine S16°E 13.45'
Measured 55'± to the water's edge of Higgins Lake

ROSCOMMON COUNTY
PEER GROUP APPROVAL

DATE Dec 11, 1996

Signature of Marvin E. Myers

Marvin E. Myers, P.S.
County Surveyor

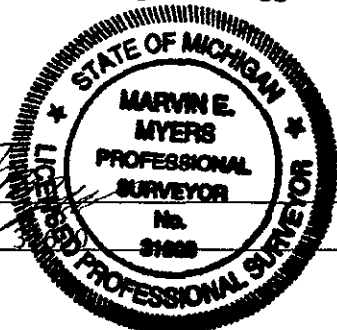

Signed by [Signature]
Surveyor's Michigan License No.

Date Dec 21, 1996

LIBER 3 PAGE 354