

**SURVEY &  
REMONUMENTATION**

MAY 28 1997

COMMISSION

9592

**LAND CORNER RECORDATION CERTIFICATE**  
Filing Requirement of Act 74, Mich. P.A. 1970

STATE OF MICHIGAN  
ROSCOMMON COUNTY  
RECORDED

For corners in

ROSCOMMON  
(County)

Located In:

Corner Code #

- |                                    |                           |             |
|------------------------------------|---------------------------|-------------|
| 1. Public Land Survey              | T <u>24</u> NR <u>3</u> W | <u>D-11</u> |
|                                    | T _____ R _____           | _____       |
|                                    | T _____ R _____           | _____       |
|                                    | T _____ R _____           | _____       |
| 2. Property Controlling in Section | S _____ T _____ R _____   | _____       |
|                                    | S _____ T _____ R _____   | _____       |
| 3. Miscellaneous Property in Sec.  | S _____ T _____ R _____   | _____       |
|                                    | S _____ T _____ R _____   | _____       |

23 DEC 96 1:01 P.M.

ROBERT W. SMITH  
REGISTER OF DEEDS

Register of Deeds Stamp & File Number

4. Lot No. \_\_\_\_\_, Recorded Plat \_\_\_\_\_
5. Private Claims \_\_\_\_\_

	A	B	C	D	E	F	G	H	I	J	K	L	M
2	6	5	4	3	2								
3													
4	7	8	9	10	11	12							
5													
6	18	17	16	15	14	13							
7													
8	19	20	21	22	23	24							
9													
10	30	29	28	27	26	25							
11													
12	31	32	33	34	35	36							
13													

I, FRANK J. ARLETH, P.S. on a field survey on NOVEMBER 6, 1996 do hereby certify that under requirements of P.A. 74, Michigan P.A. of 1970, the corner points mentioned in lines 1 and 2 above were in conformance with regulations and rules therefore as required in the current manual of survey instructions of the United States Department of the Interior, Bureau of Land Management or by a decree of a Court of Law and/or that the corner points mentioned in lines 3, 4 and 5 above were in conformance with the rules of the Michigan Board of Land Surveyors or by a Decree of a Court of Law; established, re-established, monumented, re-monumented, recovered, found as expressed below:

**NOTE: Not more than 4 corners, all in the same town and range, may be recorded on this certificate.**

A. Description of original monument and accessories and/or subsequent restoration:

- |  |   |   |
|--|---|---|
| WILLIAM BURT 1852 SET POST<br>WIT. W. PINE 24" S58°E, 25 LKS.<br>WIT. Y. PINE 10" N16°W, 25 LKS.   | 1901 PLAT OF WOODLAWN<br>NO MENTION OF 1/4-COR.<br>HENNING 1944 FD. BAR<br>AND USED IN SEC. SUB.<br>SURVEY. | CAVANAGH 1980<br>ASSESSOR'S PLAT OF WOODLAWN<br>FOUND 3/4" BAR AND REPLACED<br>WITH 4" x 36" CONC. MON. |
| DELAMETER 1929<br>FOUND GOV'T. BTS. & POST<br>SET 1/2" BAR<br>WIT. 10" W. OAK N 2°W, 37.0'<br>WIT. 18" STONE N34°E, 24.10'<br>WIT. 8" B. OAK N76 1/2°E, 63.70' | MCMAHON 1965 FD. 1/2" BAR<br>NO. WITNESS.   |   |

B. Description of corner evidence found and/or method applied in restoring or reestablishing corner:


ARLETH 1996  
FOUND CONCRETE MONUMENT 2' BELOW SURFACE  
OF BLACKTOP ROAD  
WITS. GONE  
CHECKS WITH PREVIOUS SURVEYS IN THIS AREA  
ACCEPTED AS POSITION OF ORIGINAL CORNER.

ROSCOMMON COUNTY  
PEER GROUP APPROVAL  
DATE NOV 30 1996

*Marvin E. River*  
Marvin E. River, P.S.  
County Surveyor

C. Description of monument for corner and accessories established to perpetuate locating the position of the corner:

SET ROSCOMMON COUNTY STANDARD MONUMENT IN PAV'T. BAX STAMPED 21266 D-11  
N&T 12" R. OAK N59°W, 49.60' (ON TOP OF CONC. MON.)  
N&T 5" R. PINE N12°E, 57.93'  
N&T 12" W. OAK S32°W, 54.23'  
N&T 16" B. OAK S 8°E, 42.00'  
SET CARSONITE POST AT FENCE CORNER S14°E, 33.50'

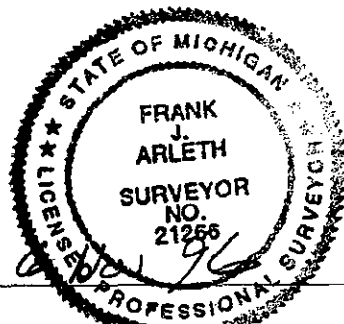

Signed by *[Signature]*  
Surveyor's Michigan License No. \_\_\_\_\_

Date \_\_\_\_\_

DATE: 8 Nov 96 PEER GROUP APPROVED. LIBER 3 DALE 377