

6831

JAN 24 1996

COMMISSION LAND CORNER RECORDATION CERTIFICATE

STATE OF MICHIGAN  
ROSCOMMON COUNTY  
RECORDED

Filing Requirement of Act 74, Mich. P.A. 1970

For corners in

6 OCT 95 1:47 P.M.

ROBERT W. SMITH  
REGISTER OF DEEDS

Roscommon (County)	Located In:	Corner Code #:
1. Public Land Survey	T <u>24</u> R <u>3 W</u>	<u>G-6</u>
	T _____ R _____	_____
	T _____ R _____	_____
	T _____ R _____	_____
2. Property Controlling in Section	S _____ T _____ R _____	<u>SURVEY &amp;</u>
	S _____ T _____ R _____	<u>MONUMENTATION</u>
3. Miscellaneous Property in Sec.	S _____ T _____ R _____	_____
	S _____ T _____ R _____	_____

TO BE FILED IN LIBER 3 OF LAND CORNER  
Register of Deeds Stamp & File Number

APR 05 1996

4. Lot No. \_\_\_\_\_, Recorded Plat \_\_\_\_\_  
5. Private Claims \_\_\_\_\_

COMMISSION

	A	B	C	D	E	F	G	H	I	J	K	L	M
2	6	5	4	3	2	1							
3													
4	7	8	9	10	11	12							
5													
6	18	17	16	15	14	13							
7													
8	19	20	21	22	23	24							
9													
10	30	29	28	27	26	25							
11													
12	31	32	33	34	35	36							
13													

I, Frank J. Arleth, in a field survey on August, 1995, do hereby certify that under requirements of P.A. 74, Michigan P.A. of 1970, the corner points mentioned in lines 1 and 2 above were in conformance with regulations and rules therefore as required in the current manual of survey instructions of the United States Department of the Interior, Bureau of Land Management or by a decree of a Court of Law and/or that the corner points mentioned in lines 3, 4 and 5 above were in conformance with the rules of the Michigan Board of Land Surveyors or by a Decree of a Court of Law; established, re-established, monumented, re-monumented, recovered, found as expressed below:


NOTE: Not more than 4 corners, all in the same town and range, may be recorded on this certificate.

- A. Description of original monument and accessories and/or subsequent restoration:  
 William Burt - 1852 Set Post S. Pine 12" S68°E 23  
 Aspen 6" N65°W 62  
 Henning 1940 Steel post in corner  
 B.T. 12" B. Oak N52°W 38.2'  
 B. T. 9" Twn. Oak S67°E 92.1'  
 Henning & Ostling 1942 Sec. Sub of 16, 2638.0' NO°50'E to NE cor. of Sec. 16, (Gov't 2643) 2622.65' S0°50'W to S.E. corner of Sec. 16 ( Gov't 2626.8) Henning 1945 Fd 3/4" pipe in corner set 1" x 24" pipe 33.0' East.  
 Ostline 1945 Set 3/4" pipe to replace steel Post which was removed by R. C. R. C. used Henning Wit of 1940.  
 Cavanagh 1987 Fd 3/4" pipe Wit: Sp P. Pole N26°W 52.15'  
 Sp. 3" W. Pine N42°E 50.0'  
 Sp 11" W. Pine S58°E 48.95'  
 Arleth 1993 Fd 3/4" pipe used same witness as Cavahagh.
- B. Description of corner evidence found and/or method applied in restoring or reestablishing corner:  
 August 1995 Fd 3/4" pipe 5' West of Centerline of Road  
 Old Witness Found: Sp. P. pole N29°W 52.15'  
 Sp. 6" W. pine N42°E 50.0'  
 Sp. 14" W. pine S58°E 48.95'

Accepted as the best available evidence of the position of original corner.

ROSCOMMON COUNTY  
PEER GROUP APPROVAL  
DATE 9-8-1995

- C. Description of monument for corner and accessories established to perpetuate locating the position of the corner:  
 Set Roscommon County Standard Monument in pav't Box- Stamped G-6, T24N, R3W, S26E, 21266  
 N & T 10" B. Oak S55°W 66.51'  
 N & T 24" W. Pine N71°W 46.1'  
 N & T P. P. S 26°E 66.34  
 Sp. P. P. P. N 29°W 52.15' ( old)  
 Sp. 6" W. pine N42°E 50.0' ( old )  
 Sp. 14" W. pine S58°E 48.95' ( old )  
 Carsonite Post West 35.0'

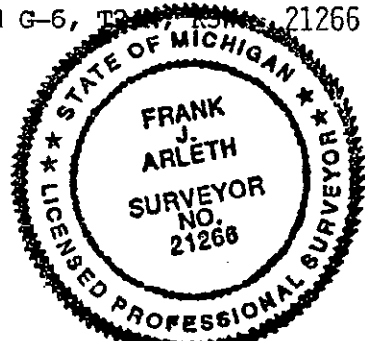

Signed by Frank J. Arleth  
Surveyor's Michigan License No. 21266 P. S.

Date 11 SEPT 95

FORM APPROVED BY MICHIGAN STATE BOARD OF LAND SURVEYORS, JAN. 28, 1971  
REVISED MAY 14, 1975  
REVISED JAN., 1983

DATE: 8 SEPT 95 PEER GROUP APPROVED LIBER 3 PAGE 260