

**SURVEY &
REMONUMENTATION**

MAY 28 1997

COMMISSION

9593

LAND CORNER RECORDATION CERTIFICATE
Filing Requirement of Act 74, Mich. P.A. 1970

STATE OF MICHIGAN
ROSCOMMON COUNTY
RECORDED

23 DEC 96 1:02 P.M.

ROBERT W. SMITH
REGISTER OF DEEDS

For corners in

<u>Roscommon</u> (County)	Located In:	Corner Code #
1. Public Land Survey	T <u>24</u> R <u>3</u> W	<u>G-12</u>
	T _____ R _____	_____
	T _____ R _____	_____
	T _____ R _____	_____
2. Property Controlling in Section	S _____ T _____ R _____	_____
	S _____ T _____ R _____	_____
3. Miscellaneous Property in Sec.	S _____ T _____ R _____	_____
	S _____ T _____ R _____	_____

Register of Deeds Stamp & File Number

4. Lot No. _____, Recorded Plat _____
5. Private Claims _____

A	B	C	D	E	F	G	H	I	J	K	L	M
2	6	5	4	3	2	1						
3												
4	7	8	9	10	11	12						
5												
6	18	17	16	15	14	13						
7												
8	19	20	21	22	23	24						
9												
10	30	29	28	27	26	25						
11												
12	31	32	33	34	35	36						
13												

I, Frank J. Arleth, in a field survey on November, 1996, do hereby certify that under requirements of P.A. 74, Michigan P.A. of 1970, the corner points mentioned in lines 1 and 2 above were in conformance with regulations and rules therefore as required in the current manual of survey instructions of the United States Department of the Interior, Bureau of Land Management or by a decree of a Court of Law and/or that the corner points mentioned in lines 3, 4 and 5 above were in conformance with the rules of the Michigan Board of Land Surveyors or by a Decree of a Court of Law; established, re-established, monumented, re-monumented, recovered, found as expressed below:

NOTE: Not more than 4 corners, all in the same town and range, may be recorded on this certificate.

A. Description of original monument and accessories and/or subsequent restoration:

William Burt 1852	R.C.R.C. 4" conc Filled pipe with brass cap
8" beech S15°W 29 lks	R. R. Sp East 69.2
8" beech N89°W 34 lks	CONC. MON. EAST 103.9'
Delamater 1926 No wit	
Delamater 1928	
BT W. Pine 6" N84°E 21.1	Ostling 1966 Found 4" conc Filled pipe with brass cap
BT W. Oak 4" S27°W 13.9	as set by DNR

DNR Ken Ostling 1964
Fd 4" conc filled pipe with brass cap
Wit: R. R. Sp Centerline of Road 69.2 East
½" bar East 103.9

B. Description of corner evidence found and/or method applied in restoring or reestablishing corner:

Found Conc. filled pipe with brass cap
Pine stump N84°E 21.1
R.R. spike East 69.2
Conc.Mon East 103.9

ROSCOMMON COUNTY


PEER GROUP APPROVAL

DATE NOV 8 1996

Marvin E. Myers
Marvin E. Myers, P.S.
County Surveyor

C. Description of monument for corner and accessories established to perpetuate locating the position of the corner:

4" conc filled pipe with brass cap
N & T 16" W. pine N25°W 1.62
N & T 16" W. pine S55°E 8.04
N & T 7" W. pine N30°E 12.05
N & T 7" W. pine S 54°W 81.80
Found ½" bar East 34.4
centerline of road 69 East
103.9 East found conc. Mon.
Carsonite post at corner.

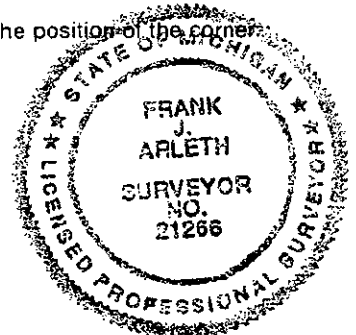

Signed by Frank J. Arleth

Date 8 Nov 96

Surveyor's Michigan License No. 21266 P. S.

Date: 8 Nov 96

Peer Group Approved.

LIBER 3 PAGE 378