

**SURVEY &
REMONUMENTATION**

MAY 28 1997

0594

COMMISSION

LAND CORNER RECORDATION CERTIFICATE
Filing Requirement of Act 74, Mich. P.A. 1970

STATE OF MICHIGAN
ROSCOMMON COUNTY
RECORDED

23 DEC 96 1:02 P.M.

ROBERT W. SMITH
REGISTER OF DEEDS

Register of Deeds Stamp & File Number

For corners in
Roscommon

(County)

Located In:

Corner Code #

- | | | |
|------------------------------------|--------------------------|------------|
| 1. Public Land Survey | T <u>24</u> R <u>3</u> W | <u>H-3</u> |
| | T _____ R _____ | _____ |
| | T _____ R _____ | _____ |
| | T _____ R _____ | _____ |
| 2. Property Controlling in Section | S _____ T _____ R _____ | _____ |
| | S _____ T _____ R _____ | _____ |
| 3. Miscellaneous Property in Sec. | S _____ T _____ R _____ | _____ |
| | S _____ T _____ R _____ | _____ |

4. Lot No. _____, Recorded Plat _____
5. Private Claims _____

	A	B	C	D	E	F	G	H	I	J	K	L	M
2	6	5	4	3	2	1							
3								0					
4	7	8	9	10	11	12							
5													
6	16	17	16	15	14	13							
7													
8	19	20	21	22	23	24							
9													
10	30	29	28	27	26	25							
11													
12	31	32	33	34	35	36							

I, Frank J. Arleth, in a field survey on June, 1996, do hereby certify that under requirements of P.A. 74, Michigan P.A. of 1970, the corner points mentioned in lines 1 and 2 above were in conformance with regulations and rules therefore as required in the current manual of survey instructions of the United States Department of the Interior, Bureau of Land Management or by a decree of a Court of Law and/or that the corner points mentioned in lines 3, 4 and 5 above were in conformance with the rules of the Michigan Board of Land Surveyors or by a Decree of a Court of Law; established, re-established, monumented, re-monumented, recovered, found as expressed below:

NOTE: Not more than 4 corners, all in the same town and range, may be recorded on this certificate.

- A. Description of original monument and accessories and/or subsequent restoration:
- | | | |
|-------------------------|-------------------------------|--------------------------------------|
| William Burt 1852 | Ostling 1946 3/4" pipe | Cavanagh 1990 3/4" pipe in Pav't Box |
| Set Post | Spike in 6" R. Oak N49°E 75.4 | U Pole N48°W 31.2 |
| 8" S. Pine N47°W 37 lks | Spike 8" J. Pine S33°W 75.5 | 10" J. pine S62°W 61.0 |
| 6" S. pine S45°W 33 lks | 8" N. pine S71°W 38.3 | 17" Oak S70°E 122.0 |
| Henning & Ostling 1943 | Ostling 1965 | U Pole N77°E 127.15 |
| Set 3/4" pipe | Witness same as 1946. | Arleth 1995 3/4" pipe in Pav't Box |
| no witness | Henning 1978 Found 3/4" pipe | Wit same as Ostling 1946. |
| | Witness same as Ostling 1946. | |


- B. Description of corner evidence found and/or method applied in restoring or reestablishing corner:

Found 3/4" pipe in pav't Box 1996
18" B. Oak S72°E 122.0
P. Pole N80°E 127.08
U. Pole N48°W 31.2

ROSCOMMON COUNTY
PEER GROUP APPROVAL
DATE June 17th 1996

Marvin E. Myers
Marvin E. Myers, P.S.
County Surveyor

- C. Description of monument for corner and accessories established to perpetuate locating the position of corner:
- Set Roscommon County Standard Mon. Stamped 21266 H-3
N & T 18 B. Oak S72°E 122.01
N & T p. ple N80°E 127.08
N & T 16" R. Oak S38°W 90.30
N & T 10" J. Pine S52°W 61.00
N & T P. Pole N50°W 31.35
Set Carsonite Post N50°W 42.0

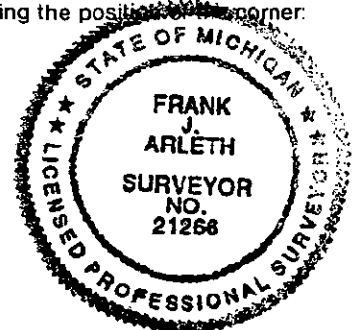

Signed by [Signature] Date June 14, 1996

Surveyor's Michigan License No. 21266 P. S.

Date: 14 June 96 Peer Group Approved.

LIBER 3 PAGE 379