

**SURVEY &  
REMONUMENTATION**

MAY 28 1997

COMMISSION

9595

**LAND CORNER RECORDATION CERTIFICATE**  
Filing Requirement of Act 74, Mich. P.A. 1970

STATE OF MICHIGAN  
ROSCOMMON COUNTY  
RECORDED

For corners in

Roscommon

(County)

Located In:

Corner Code #

23 DEC 96 1:02 P.M.

ROBERT W. SMITH  
REGISTER OF DEEDS

- |                                    |                          |            |
|------------------------------------|--------------------------|------------|
| 1. Public Land Survey              | T <u>24</u> R <u>3 W</u> | <u>H-5</u> |
|                                    | T _____ R _____          | _____      |
|                                    | T _____ R _____          | _____      |
|                                    | T _____ R _____          | _____      |
| 2. Property Controlling in Section | S _____ T _____ R _____  | _____      |
|                                    | S _____ T _____ R _____  | _____      |
| 3. Miscellaneous Property in Sec.  | S _____ T _____ R _____  | _____      |
|                                    | S _____ T _____ R _____  | _____      |

Register of Deeds Stamp & File Number

4. Lot No. \_\_\_\_\_, Recorded Plat \_\_\_\_\_
5. Private Claims \_\_\_\_\_

	A	B	C	D	E	F	G	H	I	J	K	L	M
2	6		5		4		3		2		1		
3													
4	7		8		9		10		11		12		
5								0					
6	18		17		16		15		14		13		
7													
8	19		20		21		22		23		24		
9													
10	30		29		28		27		26		25		
11													
12	31		32		33		34		35		36		
13													

I, Frank J. Arleth, in a field survey on June, 1996, do hereby certify that under requirements of P.A. 74, Michigan P.A. of 1970, the corner points mentioned in lines 1 and 2 above were in conformance with regulations and rules therefore as required in the current manual of survey instructions of the United States Department of the Interior, Bureau of Land Management or by a decree of a Court of Law and/or that the corner points mentioned in lines 3, 4 and 5 above were in conformance with the rules of the Michigan Board of Land Surveyors or by a Decree of a Court of Law; established, re-established, monumented, re-monumented, recovered, found as expressed below:

**NOTE: Not more than 4 corners, all in the same town and range, may be recorded on this certificate.**

A. Description of original monument and accessories and/or subsequent restoration:

- |   |   |
|---|---|
| William Burt 1852   | Ostling 1946                                  |
| 20" Y. pine S75°30W 191 lks   | Found well Point                              |
| 10" &. pine N86°30'E 375 lks  | 8" B. Oak S43°30W 75.6                        |
|   | 14" W. Oak N66°W 69.3                         |
| Henning 1940 Found well pt. set from Original B.t's in centerline of Road. Unknown surveyor & date. | Ostling 1964 plat of Johnston Manor L.5 P 37  |
| 8" B. Oak S43°30'W 75.6   | Ostling 1965 Johnston Manor No. 2, L. 5 P. 44 |
| 14" W. oak N66°W 69.3   |   |

- Ostling 1969 Johnston Manor No. 3, L.6 P. 33  
 Henning 1978 Found iron in Pav't box 8" B. Oak S43°E 75.6' 14" W. Oak N66°W 69.3  
 Arleth 1978 Wit. same as Hennir  
 Arleth 1982 Wit. same as Hennir  
 Fricke 1995 Pav't Box Wit. same as Henning.

B. Description of corner evidence found and/or method applied in restoring or reestablishing corner:


June 1996 Found 1/2" bar in pav't Box in centerline of County roads N&S and E&W Found 20" W. Oak N66°W 69.3'  
 Accepted as a perpetuation of the original corner.

**ROSCOMMON COUNTY  
PEER GROUP APPROVAL  
DATE Jan 17 1996**

*Marvin E. Myers*  
**Marvin E. Myers, P.S.  
County Surveyor**

C. Description of monument for corner and accessories established to perpetuate locating the position of the corner:

- Set Roscommon County Standard Monument in pav't box - stamped 21266 P.S.  
 N & T 20" W. Oak N66°W 69.3  
 N & T 8" B. Oak N41°E 83.47'  
 N & T 10" B. Oak N61°E 104.17  
 N & T 12" N. Pine S50°W 51.16  
 N & T 8 N. Pine N40°W 91.30  
 Set Carsonite Post by con. Mon. SW 46.8'

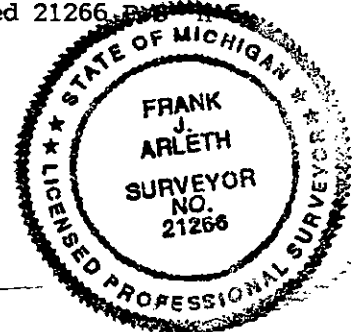

Signed by [Signature] Date June 14, 1996

Surveyor's Michigan License No 21266 P.S.

Date: 14 JUNE 96 Peer Group Approved.

LIBER 3 PAGE 380