6830 JAN 2 4 1996

COMMISSION

LAND CORNER RECORDATION CERTIFICATE

Filing Requirement of Act 74, Mich. P.A. 1970

STATE OF MICHIGAN
ROSCOMMON COUNTY
RECORDED

6 OCT 95 1:47 P.M.

ROBERT W. SMITH
REGISTER OF DEEDS

TO BE FILED IN LIBER 3 OF LAND CORNERS

Register of Deeds Stamp & File Number

For corners in Roscommon (County)

	Located In:	Corner Code ##
1. Public Land Survey	T 24 R 3 W	H-7
	T ___ R ___	
	T ___ R ___	
	T ___ R ___	
2. Property Controlling	S ___ T ___ R ___	
in Section	S ___ T ___ R ___	
3. Miscellaneous	S ___ T ___ R ___	
Property in Sec.	S ___ T ___ R ___	

SURVEY & MONUMENTATION

APR 0 5 1996

COMMISSION

4. Lot No. _____, Recorded Plat _____
5. *Private Claims* _____

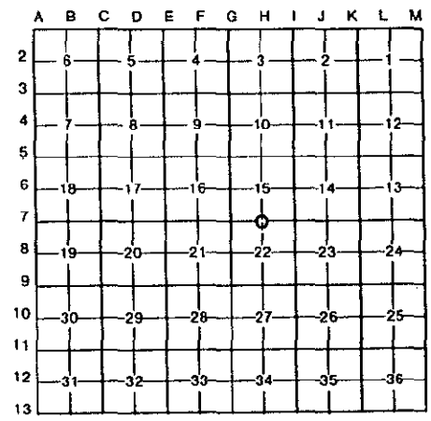

I, Frank J. Arleth, in a field survey on Sept., 19 95, do hereby certify that under requirements of P.A. 74, Michigan P.A. of 1970, the corner points mentioned in lines 1 and 2 above were in conformance with regulations and rules therefore as required in the current manual of survey instructions of the United States Department of the Interior, Bureau of Land Management or by a decree of a Court of Law and/or that the corner points mentioned in lines 3, 4 and 5 above were in conformance with the rules of the Michigan Board of Land Surveyors or by a Decree of a Court of Law; established, re-established, monumented, re-monumented, recovered, found as expressed below:

NOTE: Not more than 4 corners, all in the same town and range, may be recorded on this certificate.

A. *Description of original monument and accessories and/or subsequent restoration:*

William Burt 1852
S. Pine 10" S60 E 10
W. Pine 5 N42 W 05
Ostling 1946 July
sec. sub- of sec. 15
Fd ½" bar

Ostling Sept. 1946 Sec. sub
of Sec. 22, Fd ½" bar Mid-
point and on line
Wit: Bt 8" Triple Maple S40 W 107.5
BT 8" J. pine S59 E 77.2'
Ostling 1956 and 1972 fd ½" bar
same witness as above.

R.C.R.C. witness book
P. Pole N70 W 72.91'
P. pole N45 E 42.06'
T. pole S80 W 74.48'
Henning, Ostling, Cavanagh
Johnson and Arleth used for
numerous surveys of record.
Argus Acres L. 6 , P. 44

B. Description of corner evidence found and/or method applied in restoring or reestablishing corner:
September 1995 Found ½" bar in monument box in centerline of County Road No. 100 and Robinson Lake Road.

Accepted as the best available evidence of the position of original corner.

C. Description of monument for corner and accessories established to perpetuate locating the position of the corner:
Set Roscommon County Standard Monument in Pav't Box Stamped H-7 21266
N&T in 30" N. Pine N24°30'E 95.91'
N&T in P. Pole N76°30'E 80.05'
N&T in P. Pole S72°W 75.55'
N&T in P. Pole S26°W 60.60'
Top of Fire Hyd S43°E 82.55'
Set Carsonite Survey Post S66°W 64.2'
8" Sq. concrete USGS bench mark S66°W 63.80'

ROSCOMMON COUNTY
PEER GROUP APPROVAL
DATE 9-8-1995

Signed by Frank J. Arleth Date 15 SEPT 95

Surveyor's Michigan License No. #21266

Date 8 SEPT 95 Peer Group Approved

LIBER 3 PAGE 259

FORM APPROVED BY MICHIGAN STATE BOARD OF LAND SURVEYORS, JAN. 28, 1971
REVISED MAY 14, 1975
REVISED JAN., 1983