

6826

JAN 24 1996

COMMISSION LAND CORNER RECORDATION CERTIFICATE
Filing Requirement of Act 74, Mich. P.A. 1970

For corners in

ROSCOMMON
(County)

Located In:

Corner Code #

- 1. Public Land Survey T 24 R 3 W H-11
T _____ R _____
T _____ R _____
T _____ R _____
- 2. Property Controlling S _____ T _____ R _____
in Section S _____ T _____ R _____
- 3. Miscellaneous S _____ T _____ R _____
Property in Sec. S _____ T _____ R _____

TO BE FILED IN LIBER 3 OF LAND CORNERS
STATE OF MICHIGAN
ROSCOMMON COUNTY
RECORDED

6 OCT 95 1:46 P.M.

ROBERT W. SMITH
REGISTER OF DEEDS

Register of Deeds Stamp & File Number

- 4. Lot No. _____, Recorded Plat _____
- 5. Private Claims _____

COMMISSION

I, _____, in a field survey on _____, 19 _____, do hereby certify that under requirements of P.A. 74, Michigan P.A. of 1970, the corner points mentioned in lines 1 and 2 above were in conformance with regulations and rules therefore as required in the current manual of survey instructions of the United States Department of the Interior, Bureau of Land Management or by a decree of a Court of Law and/or that the corner points mentioned in lines 3, 4 and 5 above were in conformance with the rules of the Michigan Board of Land Surveyors or by a Decree of a Court of Law; established, re-established, monumented, re-monumented, recovered, found as expressed below:

NOTE: Not more than 4 corners, all in the same town and range, may be recorded on this certificate.

A	B	C	D	E	F	G	H	I	J	K	L	M
2	6	5	4	3	2	1						
3												
4	7	8	9	10	11	12						
5												
6	18	17	16	15	14	13						
7												
8	19	20	21	22	23	24						
9												
10	30	29	28	27	26	25						
11												
12	31	32	33	34	35	36						
13												

A. Description of original monument and accessories and/or subsequent restoration:

WILLIAM BURT 1852 SET POST
HEMLOCK 30" S13°W
HEMLOCK 18" N35°W 8 LKS.

PLAT CORNER OF ALMEDA BEACH
RECORDED IN L, 1 OF PLATS
P, 46 AND REVISED PLAT OF
ALMEDA BEACH RECORDED IN
L, 2 OF PLATS P, 46.

FRICKE 1981 FD. 1/2" BAR
WIT. 1/2" BAR WEST 33.0'
WIT. CON. MON. EAST 33.0'

DeLAMATER 1924 FOUND US BTS. & POST
SET 1 1/2" PIPE IN CORNER
1 1/2" GAS PIPE S53°W 34.4'
CONC. MON. N22°W 89.2'
CONC. MON. S89°30'E 33.0'

R.C.R.C. FOUND 1/2" BAR
WIT. SP. IN 4" BIRCH S80°E 50.24'
WIT. SP. IN 9" BALSAM S60°E 50.25'
WIT. SP. IN 9" BALSAM S20°E 62.17'

ARLETH 1981 FD. 1/2" BAR
FD. CONC. MON. EAST 33.0'
ARLETH 1987 FD. 1/2" BAR
FD. CONC. MON.
EAST 33.0'
FD. CONC. MON.
N22 W 89.2'

B. Description of corner evidence found and/or method applied in restoring or reestablishing corner:

SEPT. 1995 FOUND 1/2" BAR
WIT. FOUND CONC. MON. EAST 33.0'
WIT. FOUND CONC. MON. N22 W 89.2'


ACCEPTED AS THE BEST AVAILABLE EVIDENCE OF THE POSITION OF THE ORIGINAL CORNER.

ROSCOMMON COUNTY
PEER GROUP APPROVAL

DATE 9-8-1995 MEM

C. Description of monument for corner and accessories established to perpetuate locating the position of the corner:

SET ROSCOMMON COUNTY STANDARD MONUMENT STAMPED T24N R3W H-11 21266
WIT. CONC. MON. S89°30'E 33.0' (OLD)
WIT. NAIL & TAG IN 14" W. PINE N51°30'E 51.75'
WIT. NAIL & TAG IN 16" W. PINE S46°E 36.90'
WIT. NAIL & TAG IN 5" BALSAM S87°30'E 22.57'
WIT. NAIL & TAG IN POWER POLE N23°E 92.18'
CENTERLINE OF COUNTY ROAD # 100 WEST 58.0'
CARSONITE POST S45°E, 1.0'
WIT. CONC. MON. N22 W 89.2' (OLD)

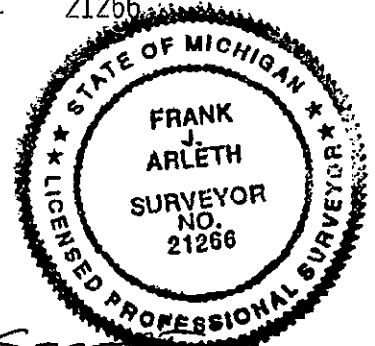

Signed by Frank J. Arleth
Surveyor's Michigan License No. 21266

Date 11 SEPT 95