

**SURVEY &  
REMONUMENTATION**

MAY 28 1997

COMMISSION

9597

**LAND CORNER RECORDATION CERTIFICATE  
Filing Requirement of Act 74, Mich. P.A. 1970**

STATE OF MICHIGAN  
ROSCOMMON COUNTY  
RECORDED

For corners in  
Roscommon  
(County)

Located In: \_\_\_\_\_ Corner Code # \_\_\_\_\_

23 DEC 96 1:02 P.M.

- |                                    |                            |            |
|------------------------------------|----------------------------|------------|
| 1. Public Land Survey              | T <u>24</u> N R <u>3</u> W | <u>I-4</u> |
|                                    | T _____ R _____            | _____      |
|                                    | T _____ R _____            | _____      |
|                                    | T _____ R _____            | _____      |
| 2. Property Controlling in Section | S _____ T _____ R _____    | _____      |
|                                    | S _____ T _____ R _____    | _____      |
| 3. Miscellaneous Property in Sec.  | S _____ T _____ R _____    | _____      |
|                                    | S _____ T _____ R _____    | _____      |

ROBERT W. SMITH  
REGISTER OF DEEDS

Register of Deeds Stamp & File Number

4. Lot No. \_\_\_\_\_, Recorded Plat \_\_\_\_\_  
5. Private Claims \_\_\_\_\_

| A  | B  | C  | D  | E  | F  | G  | H | I | J | K | L | M |
|----|----|----|----|----|----|----|---|---|---|---|---|---|
| 2  | 6  | 5  | 4  | 3  | 2  | 1  |   |   |   |   |   |   |
| 3  |    |    |    |    |    |    |   |   |   |   |   |   |
| 4  | 7  | 8  | 9  | 10 | 11 | 12 |   |   |   |   |   |   |
| 5  |    |    |    |    |    |    |   |   |   |   |   |   |
| 6  | 18 | 17 | 16 | 15 | 14 | 13 |   |   |   |   |   |   |
| 7  |    |    |    |    |    |    |   |   |   |   |   |   |
| 8  | 19 | 20 | 21 | 22 | 23 | 24 |   |   |   |   |   |   |
| 9  |    |    |    |    |    |    |   |   |   |   |   |   |
| 10 | 30 | 29 | 28 | 27 | 26 | 25 |   |   |   |   |   |   |
| 11 |    |    |    |    |    |    |   |   |   |   |   |   |
| 12 | 31 | 32 | 33 | 34 | 35 | 36 |   |   |   |   |   |   |
| 13 |    |    |    |    |    |    |   |   |   |   |   |   |

I, Frank J. Arleth, in a field survey on June, 1996, do hereby certify that under requirements of P.A. 74, Michigan P.A. of 1970, the corner points mentioned in lines 1 and 2 above were in conformance with regulations and rules therefore as required in the current manual of survey instructions of the United States Department of the Interior, Bureau of Land Management or by a decree of a Court of Law and/or that the corner points mentioned in lines 3, 4 and 5 above were in conformance with the rules of the Michigan Board of Land Surveyors or by a Decree of a Court of Law; established, re-established, monumented, re-monumented, recovered, found as expressed below:

**NOTE: Not more than 4 corners, all in the same town and range, may be recorded on this certificate.**

A. Description of original monument and accessories and/or subsequent restoration:

- |  |   |   |
|--|---|---|
| <b>William Burt 1852</b><br>Set Post<br>Wit. 18" Y. Pine N12°E, 154 lks.<br>Wit. 18" Y. Pine S29°W, 131 lks. | <b>Henning 1983</b><br>Fd. 1/2" bar in Pav't. Box<br>No Witness                 | <b>Arleth 1994</b><br>Fd. 1/2" bar in Pav't. Box<br>Wit. 1/2" bar North, 33.00'<br>Wit. 20" W. Oak S30°E, 39.50'<br>Wit. 16" B. Oak N55°E, 54.75'<br>Wit. 7" W. Oak S40°W, 45.00'<br>Wit. P. Pole N60°W, 70.10'<br>Fricke No. 21781 1995<br>Fd. 1/2" bar in Pav't. Box<br>Same Witness. |
| <b>DeLamater 1929</b><br>Set 1/2" bar<br>No Witness  | <b>R.C.R.C.</b><br>Fd. 1/2" bar in Pav't. Box<br>Centerline of Maplehurst Road. |   |

B. Description of corner evidence found and/or method applied in restoring or reestablishing corner:

- Fd. 1/2" bar in Pav't. Box centerline of Maplehurst Road.  
Fd. 1/2" bar 33.00' South  
Found all witnesses from 1994 Survey (Arleth)


Accepted as the best available evidence of the position of the original corner.

**ROSCOMMON COUNTY  
PEER GROUP APPROVAL  
DATE JUNE 17 1996**

*Marvin E. Hynes*

C. Description of monument for corner and accessories established to perpetuate locating the position of the corner:

- SET ROSCOMMON COUNTY STANDARD MONUMENT IN PAV'T. BOX - **STAMPED I-4**  
Wit. N&T in P. Pole N60°W, 70.00'  
Wit. N&T in 24" W. Oak S30°E, 39.48'  
Wit. N&T in 8" W. Oak S40°W, 45.17'  
Wit. N&T in 16" B. Oak N55°E, 54.70'  
Wit. 1/2" bar North, 33.00'  
Wit. 1/2" bar South, 33.00'  
Set Carsonite Post South 33.00'

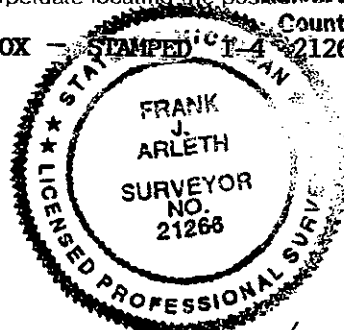

Signed by *Frank J. Arleth* Date 17 June 96  
Surveyor's Michigan License No. 21266 P.S.

DATE: 17 June 96 PEER GROUP APPROVED  
1, 2, 100