

**SURVEY &  
REMONUMENTATION**

9690

MAY 28 1997

**LAND CORNER RECORDATION CERTIFICATE  
Filing Requirement of Act 74, Mich. P.A. 1970**

For corners in

<u>Roscommon</u> (County)	Located In:	Corner Code #
1. Public Land Survey	T <u>24N</u> R <u>3 W</u>	<u>I-5</u>
	T _____ R _____	_____
	T _____ R _____	_____
	T _____ R _____	_____
2. Property Controlling in Section	S _____ T _____ R _____	_____
	S _____ T _____ R _____	_____
3. Miscellaneous Property in Sec.	S _____ T _____ R _____	_____
	S _____ T _____ R _____	_____
4. Lot No. _____, Recorded Plat _____		
5. Private Claims _____		

STATE OF MICHIGAN  
ROSCOMMON COUNTY  
RECORDED

27 DEC 96 2:16 P.M.

ROBERT W. SMITH  
REGISTER OF DEEDS

Register of Deeds Stamp & File Number

I, Frank J. Arleth, in a field survey on June, 1996, do hereby certify that under requirements of P.A. 74, Michigan P.A. of 1970, the corner points mentioned in lines 1 and 2 above were in conformance with regulations and rules therefore as required in the current manual of survey instructions of the United States Department of the Interior, Bureau of Land Management or by a decree of a Court of Law and/or that the corner points mentioned in lines 3, 4 and 5 above were in conformance with the rules of the Michigan Board of Land Surveyors or by a Decree of a Court of Law; established, re-established, monumented, re-monumented, recovered, found as expressed below:

**NOTE: Not more than 4 corners, all in the same town and range, may be recorded on this certificate.**

	A	B	C	D	E	F	G	H	I	J	K	L	M
2	6	5	4	3	2	1							
3													
4	7	8	9	10	11	12							
5													
6	18	17	16	15	14	13							
7													
8	19	20	21	22	23	24							
9													
10	30	29	28	27	26	25							
11													
12	31	32	33	34	35	36							
13													

**A. Description of original monument and accessories and/or subsequent restoration:**

William Burt 1852  
Set Post  
Wit. 8" S. Pine S6°W, 61 lks.  
Wit. 8" S. Pine N72°E, 24 lks.

Myers 1989  
Fd. Log Spike  
No Witness

Myers 1991  
Fd. Log Spike  
No Witness

DeLamater 1929  
Set 1/2" bar & post  
Pointed Stone N55°W, 48.10'  
Large Stone S76°E, 117.40'

Ostling 1964  
No Witness

**B. Description of corner evidence found and/or method applied in restoring or reestablishing:**

1996 Fd. Log Spike set over 1/2" bar  
Fd. Pointed Stone N55°W, 48.10'  
Fd. 1/2" bar S01°33'24"W, 33.00'  
Large Stone moved by C.P.C.


**ROSCOMMON COUNTY  
PEER GROUP APPROVAL**

DATE June 17, 1996  
*Marvin E. Myers*  
Marvin E. Myers, P.S.  
County Surveyor

Accepted as the best available evidence of the position of the original corner.

**C. Description of monument for corner and accessories established to perpetuate locating the position of the corner:**

SET ROSCOMMON COUNTY STANDARD MONUMENT - STAMPED I-5  
N&T P. Pole S44°E, 43.30'  
N&T 14" N. Pine N46°W, 98.60'  
N&T 10" J. Pine S23°W, 66.58'  
N&T 24" B. Oak N29°E, 80.37'  
1/2" Bar S01°33'24"W, 33.00'  
Pointed Stone N55°W, 48.10'  
Set Carsonite Post 33.00' South

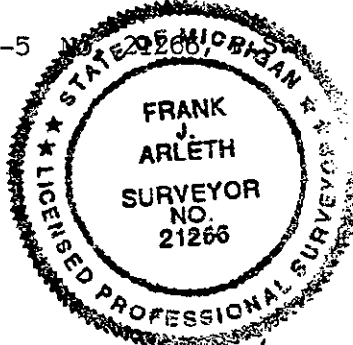

Signed by *Frank J. Arleth*  
Surveyor's Michigan License No. 21266 P.S.

Date 17 June 96

DATE" 17 June 96

FORM APPROVED BY MICHIGAN STATE BOARD OF LAND SURVEYORS, JAN. 28, 1971  
REVISED MAY 14, 1975  
REVISED JAN., 1983

PEER GROUP APPROVED. LIBER 3 PAGE 389