

6538

JAN 24 1995

COMMISSION LAND CORNER RECORDATION CERTIFICATE

Filing Requirement of Act 74, Mich. P.A. 1970

For corners in Roscommon (County)

Located In: Corner Code #

- 1. Public Land Survey T 24 R 3 W I-7
2. Property Controlling in Section S T R
3. Miscellaneous Property in Sec. S T R

STATE OF MICHIGAN ROSCOMMON COUNTY RECORDED

6 OCT 95 1:49 P.M.

ROBERT W. SMITH REGISTER OF DEEDS

TO BE FILED IN LIBER 3 OF LAND CORNERS Register of Deeds Stamp & File Number

APR 05 1995

- 4. Lot No. Recorded Plat
5. Private Claims

COMMISSION

I, Frank J. Arleth, in a field survey on August, 1995, do hereby certify that under requirements of P.A. 74, Michigan P.A. of 1970, the corner points mentioned in lines 1 and 2 above were in conformance with regulations and rules therefore as required in the current manual of survey instructions of the United States Department of the Interior, Bureau of Land Management or by a decree of a Court of Law and/or that the corner points mentioned in lines 3, 4 and 5 above were in conformance with the rules of the Michigan Board of Land Surveyors or by a Decree of a Court of Law; established, re-established, monumented, re-monumented, recovered, found as expressed below:

NOTE: Not more than 4 corners, all in the same town and range, may be recorded on this certificate.

A. Description of original monument and accessories and/or subsequent restoration:

- William Burt 1852 Ostling 1946 Fd bar
S. Pine 5" N51W 1.28 Wit: 10" J. Pine S55°30'E 88.5'
S. Pine 6 S42°E 98 8" N. Pine S 12°E 96.3'
DeLamater 1929 M.C.G.C. Verba 1965 Fd 1/2" bar
1/2" x 30" Bar in cor. P.K. 6" R. Pine Az 156° 67.6'
mound of earth N60°E ? P. K. T.pole As 202° 31.8'
P... 6" J. pine Az 346°114.3'
N. End Metal culvert Az 324°24'

- JOHNSON 30083 P.S. 1986 -D.N.R.
Fd Mon Box No Witness
Arleth 1995 Fd 1/2" bar in Pav't box
Wit: 1/2" bar N0 25'E 45.0
Sp. 12" N. pine S26°W 67.50'
Sp. 7" Aspen S29°W 78.15'
Sp. 8" J. Pine N36°E 87.75'
Sp. 8" J. Pine N13°W 54.30'

B. Description of corner evidence found and/or method applied in restoring or reestablishing corner:

- Aug. 1995 Fd 1/2" bar in pav't box in Centerline of Road
OLD Wit. Fd= Sp. 7" Aspen S29°W 78.15'
Sp. 8" J. pine N36°E 87.75'
1/2" bar N0°25'E 45.0'


Accepted as the best available evidence of the position of original corner.

ROSCOMMON COUNTY PEER GROUP APPROVAL

DATE Sept 29, 1995

C. Description of monument for corner and accessories established to perpetuate locating the position of the corner: Set Roscommon County standard Monument in Pav't Box STAMPED I-7 T24N R3W 21266

- N & T 4" Maple S5°W 69.30'
N & T 14" N. Pine S26°E 67.41
Sp. 7" Aspen S29°W 78.15' (old)
8" J. Pine N36°E 87.75' (old)
1/2" bar N0°25'E 45.0'
Carsonite Post South 49.0'

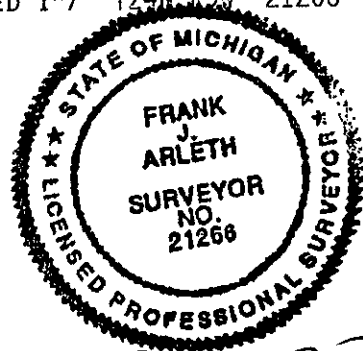

Signed by [Signature] Date 11 SEPT 95
Surveyor's Michigan License No. 21266 P.S.

DATE: 8 SEPT 95 PEER GROUP APPROVED FORM APPROVED BY MICHIGAN STATE BOARD OF LAND SURVEYORS, JAN. 20, 1971 REVISED MAY 14, 1975 REVISED JAN., 1983

LIBER 3 PAGE 267