

7345

JAN 24 1996
COMMISSION

LAND CORNER RECORDATION CERTIFICATE
Filing Requirement of Act 74, Mich. P.A. 1970

For corners in
ROSCOMMON
(County)

Located In: Corner Code #

- 1. Public Land Survey T 24 R 3 W I-8
- 2. Property Controlling in Section S T R SURVEY & MONUMENTATION
- 3. Miscellaneous Property in Sec. S T R

TO BE FILED IN LIBER 3 OF LAND CORNER:

STATE OF MICHIGAN
ROSCOMMON COUNTY
RECORDED

24 OCT 95 11:40 A.M.

ROBERT W. SMITH
REGISTER OF DEEDS

Register of Deeds Stamp & File Number

- 4. Lot No. _____ Recorded Plat _____
- 5. Private Claims _____ COMMISSION

A	B	C	D	E	F	G	H	I	J	K	L	M
2	6	5	4	3	2	1						
3												
4	7	8	9	10	11	12						
5												
6	18	17	16	15	14	13						
7												
8	19	20	21	22	23	24						
9												
10	30	29	28	27	26	25						
11												
12	31	32	33	34	35	36						
13												

I, _____, in a field survey on _____, 19____, do hereby certify that under requirements of P.A. 74, Michigan P.A. of 1970, the corner points mentioned in lines 1 and 2 above were in conformance with regulations and rules therefore as required in the current manual of survey instructions of the United States Department of the Interior, Bureau of Land Management or by a decree of a Court of Law and/or that the corner points mentioned in lines 3, 4 and 5 above were in conformance with the rules of the Michigan Board of Land Surveyors or by a Decree of a Court of Law; established, re-established, monumented, re-monumented, recovered, found as expressed below:

NOTE: Not more than 4 corners, all in the same town and range, may be recorded on this certificate.

A. Description of original monument and accessories and/or subsequent restoration:

WILLIAM BURT 1852 SET POST
WIT. S. PINE 8" N25°E 38 LKS.

DELAMTER 1924 SET 1/2" BAR IN CORNER
SET MID-WAY & ON LINE
WIT. POINTED STONE N45°E 49.0'
WIT. PIT WITH STONES S45°E 55.0'

JOHNSON #30083 DNR. 1986
SET DNR MON. & POST IN PLACE OF 1/2" BAR
WIT. 12" J. PINE N22°W 85.3'
WIT. 5" R. OAK N69°E 53.3'
WIT. 6" W. PINE S22°E 70.8'
CENTERLINE OF TRAIL ROAD NORTH 8'

B. Description of corner evidence found and/or method applied in restoring or reestablishing corner:

AUG. 1995 FOUND DNR MON. & POST
WIT. 12" J. PINE N22°W 85.3'
WIT. 5" R. OAK N69°E 53.3'
WIT. 6" W. PINE S22°E 70.8' (STUMP)
POINT STONE N45°E 49.0'
PIT WITH STONES S45°E 35.0'


ROSCOMMON COUNTY
PEER GROUP APPROVAL
DATE Sept 8, 1995

W.R.M.

ACCEPTED AS THE BEST AVAILABLE EVIDENCE OF THE POSITION OF THE ORIGINAL CORNER.

C. Description of monument for corner and accessories established to perpetuate locating the position of the corner:

I-8 CORNER COMMON TO SECTIONS 22 & 23
DNR MONUMENT (CAP ON A 1" PIPE)
N&T 6" R. OAK N 3°E 58.91'
N&T 8" R. OAK N69°E 53.55'
N&T 4" J. PINE S45°E 16.45'
N&T 4" POPPLE S86°W 24.42'
CENTER OF CULVERT N80°W 14.30'
CENTER OF DITCH 15.0' WEST
CENTER OF DITCH 30.0' SOUTH
CARSONITE POST SET BY CORNER

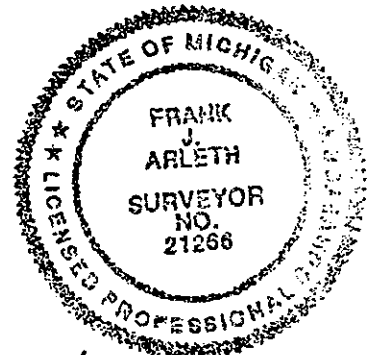

Signed by Frank J. Arleth Date 10/19/95
Surveyor's Michigan License No. #21266

DATE 8 SEPT 95 PEER GROUP APPROVED.
LIBER 3 PAGE 268