

7346

JAN 24 1995

COMMISSIONED CORNER RECORDATION CERTIFICATE  
Filing Requirement of Act 74, Mich. P.A. 1970

For corners in

Roscommon (County) Located In: \_\_\_\_\_ Corner Code # I-9

1. Public Land Survey T 24 R 3 W \_\_\_\_\_ I-9  
 T \_\_\_\_\_ R \_\_\_\_\_  
 T \_\_\_\_\_ R \_\_\_\_\_  
 T \_\_\_\_\_ R \_\_\_\_\_

2. Property Controlling S \_\_\_\_\_ T \_\_\_\_\_ R \_\_\_\_\_  
 in Section S \_\_\_\_\_ T \_\_\_\_\_ R \_\_\_\_\_

3. Miscellaneous S \_\_\_\_\_ T \_\_\_\_\_ R \_\_\_\_\_  
 Property in Sec. S \_\_\_\_\_ T \_\_\_\_\_ R \_\_\_\_\_

4. Lot No. \_\_\_\_\_, Recorded Plat \_\_\_\_\_

5. Private Claims \_\_\_\_\_ APR 05 1996

TO BE FILED IN LIBER 3 OF LAND CORNERS

STATE OF MICHIGAN  
ROSCOMMON COUNTY  
RECORDED

24 OCT 95 11:40 A.M.

ROBERT W. SMITH  
Register of Deeds State of Michigan

**SURVEY & MONUMENTATION**

A	B	C	D	E	F	G	H	I	J	K	L	M
2	6	5	4	3	2	1						
3												
4	7	8	9	10	11	12						
5												
6	18	17	16	15	14	13						
7												
8	19	20	21	22	23	24						
9												
10	30	29	28	27	26	25						
11												
12	31	32	33	34	35	36						
13												

COMMISSION

I, Frank J. Arleth in a field survey on August, 19 95, do hereby certify that under requirements of P.A. 74, Michigan P.A. of 1970, the corner points mentioned in lines 1 and 2 above were in conformance with regulations and rules therefore as required in the current manual of survey instructions of the United States Department of the Interior, Bureau of Land Management or by a decree of a Court of Law and/or that the corner points mentioned in lines 3, 4 and 5 above were in conformance with the rules of the Michigan Board of Land Surveyors or by a Decree of a Court of Law; established, re-established, monumented, re-monumented, recovered, found as expressed below:

NOTE: Not more than 4 corners, all in the same town and range, may be recorded on this certificate.

- A. Description of original monument and accessories and/or subsequent restoration:
- William Burt 1852 S. Pine 6 N76°E 13 Tamarack 5 N35°W 36
  - DeLaMater 1924 Fd U.S. Bts. & post Set 1/2" bar in corner Pointed stone S45°E 50' Pit with stones N45°E 50' Large stone S89°E 68.8'
  - Arleth 1976 Fd 1/2" bar Pointed stone S45°E 50.0' Pit with Stone N45°E 50.0' 8" J. Pine N45°E 37.6' 9" J. pine N43°W 47.3'


Johnson - DNR 1987  
Fd 1/2" bar  
No new witness  
R.C.R.C. witness book  
Pointed Stone S45°E 50'  
8" J. Pine N45°E 37.6'  
9" J. Pine N43°E 47.3'

- B. Description of corner evidence found and/or method applied in restoring or reestablishing corner:
- August 1995 Found 1/2" bar
  - Found old witness: pointed stone S45°E 50.0'
  - Old wit. pit with stones N45°E 50' stone S89°E 68.8'
  - Old wit. 8" J. Pine N45°E 37.6' (stump)
  - Old wit. 9" J. Pine N43°W 47.3 (down)

ROSCOMMON COUNTY  
PEER GROUP APPROVAL  
DATE SEP 8, 1995

Accepted as the best available evidence of the position of original corner.

- C. Description of monument for corner and accessories established to perpetuate locating the position of the corner:
- I-9 Corner common to Sections 22, 23, 26 & 27
  - Set Roscommon County Standard Monument over 1/2" Bar Stamped #21266
  - N&T 4" Maple S24°E 16.53'
  - N&T 10" N. Pine N61°E 46.55'
  - N&T 5" Maple N79°E 7.60'
  - N&T 10" Maple N19°E 58.51'
  - Centerline of ditch 15.0' West
  - Carsonite Post set by corner.

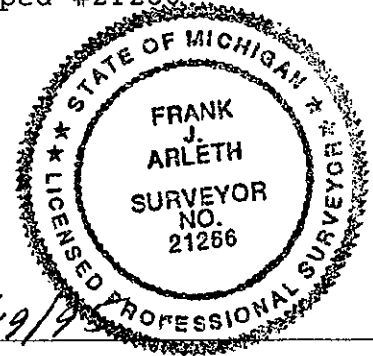

Signed by Frank J. Arleth Date 10/19/95  
Surveyor's Michigan License No. 21266 P. S.

Date: 8 SEPT 95 Peer Group Approved LIBER 3 PAGE 719