

7347

JAN 24 1996

COMMISSION LAND CORNER RECORDATION CERTIFICATE
Filing Requirement of Act 74, Mich. P.A. 1970

For corners in

Roscommon
(County)

Located In:

Corner Code #

TO BE FILED IN LIBER 3 OF LAND CORNER:

- 1. Public Land Survey T 24 R 3 W I-10
- T _____ R _____
- T _____ R _____
- T _____ R _____
- 2. Property Controlling S _____ T _____ R _____
- in Section S _____ T _____ R _____
- 3. Miscellaneous S _____ T _____ R _____
- Property in Sec. S _____ T _____ R _____

STATE OF MICHIGAN
ROSCOMMON COUNTY
RECORDED

24 OCT 95 11:40 A.M.

ROBERT W. SMITH
Register of Deeds Stamp & File Number

- 4. Lot No. _____, Recorded Plat APR 05 1996
- 5. Private Claims _____

COMMISSION

A	B	C	D	E	F	G	H	I	J	K	L	M
2	6	5	4	3	2	1						
3												
4	7	8	9	10	11	12						
5												
6	18	17	16	15	14	13						
7												
8	19	20	21	22	23	24						
9												
10	30	29	28	27	26	25						
11												
12	31	32	33	34	35	36						
13												

I, _____, in a field survey on _____, 19 _____, do hereby certify that under requirements of P.A. 74, Michigan P.A. of 1970, the corner points mentioned in lines 1 and 2 above were in conformance with regulations and rules therefore as required in the current manual of survey instructions of the United States Department of the Interior, Bureau of Land Management or by a decree of a Court of Law and/or that the corner points mentioned in lines 3, 4 and 5 above were in conformance with the rules of the Michigan Board of Land Surveyors or by a Decree of a Court of Law; established, re-established, monumented, re-monumented, recovered, found as expressed below:

NOTE: Not more than 4 corners, all in the same town and range, may be recorded on this certificate.

- A. Description of original monument and accessories and/or subsequent restoration:
William Burt set Post Arleth 1976
B. Ash 14" N59°E 30 Fd bottom of Cedar post
Y. Birch 6" S44°W 11 in swamp. Top rotten off,
DelaMater 1924 Set Cedar Post set 1/2" x 48" bar & post
Fd. U. S. Bts. Wit: 4" ash North 10.7'
nbt 8" Birch N40°E 17.3' 10" Cedar N80°W 13.5'
nbt 8" B. Ash S71°E 29.6' 8" Ash S20°E 16.5'

- B. Description of corner evidence found and/or method applied in restoring or reestablishing corner:
Sept. 1995 Fd 1/2" bar
Old wit: 10 Cedar N80°W 13.5'
Old wit. 8" Ash S20°E 16.5' (down)
Old wit. 8" Birch N40°E 17.3'

ROSCOMMON COUNTY
PEER GROUP APPROVAL


DATE SEPT 8, 1995

MEM

Accepted as best available evidence of the position of the original corner and replaced with Standard Monument.

- C. Description of monument for corner and accessories established to perpetuate locating the position of the corner:

I-10 corner common to Sections 26 & 27
Set Roscommon County Standard Monument Stamped #21266
N&T 10" Cedar N80°W 13.92'
N&T 8" Cedar S50°W 21.01'
N&T 8" Tw. Maple S12°E 23.15'
N&T 3" Spruce East 16.18'
Carsonite Post set by corner

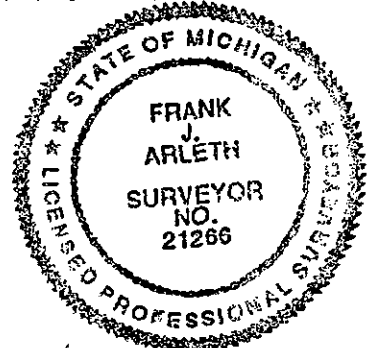

Signed by Frank J. Arleth
Surveyor's Michigan License No. 21266 P.S.

Date 10/19/95

DATE 8 SEPT 95

PEER GROUP APPROVED

LIBER 3 PAGE 57A