


LAND CORNER RECORDATION CERTIFICATE
Filing Requirement of Act 74, Mich P.A. 1970

For corners in
Roscommon County

Located in: Corner Code #

1. Public Land Survey

T24N	R3W	J-1
_____	_____	_____
T_____	R_____	_____
T_____	R_____	_____
T_____	R_____	_____

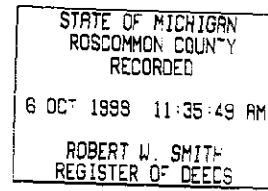

FILE IN LIBER 3 OF LAND CORNERS
Register of Deeds Stamp & File Number

I, Larry L. Cavanagh, in a field survey July 1999, do hereby certify that under requirements of P.A. 74, Michigan P.A. of 1970, the corner points mentioned in line 1 above was in conformance with regulations and rules therefore as required in the current manual of survey instructions of the United States Department of the Interior, Bureau of Land Management or by a decree of a Court of Law, established, re-established, monumented, recovered, found as expressed below:

A. Description of original monument and accessories and/or subsequent restoration:

JOHN BRINK, GLO 1839
SET QUARTER POST
HEMLOCK 10° N24°W 12 LKS
BIRCH 10° N63°E 10 LKS

ROBERT T. OSTLING, RLS, 1946
SECTION SURVEY
5/8" X 18" BOLT

CORNER 11.2 SOUTH OF CENTERLINE
SPIKE IN BASE OF W. PINE 20' S26°E 28.7'
SPIKE IN BASE OF HENLOCK S10°W 34.0'

FRANK J. ARLETH, 1990
SURVEY, L339, P381
FD R.R. SPIKE 11.5 SOUTH OF CENTERLINE
OF M-76
8' CEDAR S44°W 57.6'
14' MAPLE S50°E 76.1'

A	B	C	D	E	F	G	H	I	J	K	L	M
2	6	5	4	3	2	1						
3												
4	7	8	9	10	11	12						
5												
6	18	17	16	15	14	13						
7												
8	19	20	21	22	23	24						
9												
10	30	29	28	27	26	25						
11												
12	31	32	33	34	35	36						
13												

B. Description of corner evidence found and/or method applied in restoring or reestablishing corner:

FOUND PAVEMENT BOX (NO MONUMENT) 11.2 SOUTH OF CENTERLINE
FOUND FRANK ARLETH'S BAR 100.0' NORTH
MDOT REFERENCE HUB 71.57' NORTH
FOUND 8' CEDAR (NOW 9') S44°W 57.75'


THE BEST AVAILABLE EVIDENCE OF THE POSITION OF THE ORIGINAL CORNER

C. Description of monument for corner and accessories established to perpetuate locating the position of the corner:

SET STANDARD MONUMENT IN PAVEMENT BOX FROM WITNESSES
WIT: NAIL & TAG IN 9' CEDAR S44°W 57.75'
NAIL & TAG IN 15' W. PINE N42°E 88.17'
NAIL & TAG IN 8' TWIN MAPLE N43°W 61.41'
NAIL & TAG IN 7' W. PINE S31°E 39.30'
CARSONITE POST SOUTH 21.2

ROSCOMMON COUNTY
PEER GROUP APPROVAL
DATE Sept 10, 1999

Marvin E. Myers
Marvin E. Myers, P.S.
County Surveyor

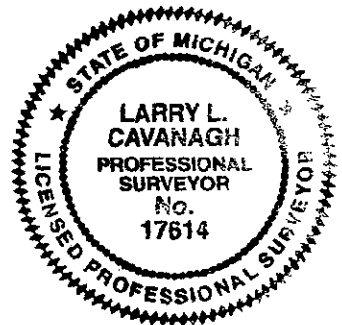

Signed by Larry L. Cavanagh
Surveyor's Michigan License NO. 17614

Date Sept 14, 1999

FORM APPROVED BY MICHIGAN STATE BOARD OF LAND SURVEYORS, JAN 28, 1971
REVISED MAY 14, 1975
REVISED JAN., 1983



SURVEY & RECORDS SECTION

MAR 01 2000

SECTION