

**SURVEY &  
REMONUMENTATION**

MAY 28 1997

COMMISSION

9599

**LAND CORNER RECORDATION CERTIFICATE  
Filing Requirement of Act 74, Mich. P.A. 1970**

STATE OF MICHIGAN  
ROSCOMMON COUNTY  
RECORDED

23 DEC 96 1:03 P.M.

ROBERT W. SMITH  
REGISTER OF DEEDS

For corners in

Roscommon

(County)

Located in:

Corner Code #

- |                                       |                          |            |
|---------------------------------------|--------------------------|------------|
| 1. Public Land Survey                 | T <u>24</u> R <u>3</u> W | <u>J-3</u> |
|                                       | T _____ R _____          | _____      |
|                                       | T _____ R _____          | _____      |
|                                       | T _____ R _____          | _____      |
| 2. Property Controlling<br>in Section | S _____ T _____ R _____  | _____      |
|                                       | S _____ T _____ R _____  | _____      |
| 3. Miscellaneous<br>Property in Sec.  | S _____ T _____ R _____  | _____      |
|                                       | S _____ T _____ R _____  | _____      |

Register of Deeds Stamp & File Number

4. Lot No. \_\_\_\_\_, Recorded Plat \_\_\_\_\_  
5. Private Claims \_\_\_\_\_

	A	B	C	D	E	F	G	H	I	J	K	L	M
2	6	5	4	3	2	1							
3										●			
4	7	8	9	10	11	12							
5													
6	18	17	16	15	14	13							
7													
8	19	20	21	22	23	24							
9													
10	30	29	28	27	26	25							
11													
12	31	32	33	34	35	36							
13													

I, Frank J. Arleth, in a field survey on November, 1996, do hereby certify that under requirements of P.A. 74, Michigan P.A. of 1970, the corner points mentioned in lines 1 and 2 above were in conformance with regulations and rules therefore as required in the current manual of survey instructions of the United States Department of the Interior, Bureau of Land Management or by a decree of a Court of Law and/or that the corner points mentioned in lines 3, 4 and 5 above were in conformance with the rules of the Michigan Board of Land Surveyors or by a Decree of a Court of Law; established, re-established, monumented, re-monumented, recovered, found as expressed below:

**NOTE: Not more than 4 corners, all in the same town and range, may be recorded on this certificate.**

- A. Description of original monument and accessories and/or subsequent restoration:  
 William Burt 1852      Ostling 1946 5/8" x 18" Iron Bar  
 Y. Pine 20" S32°W 41 lks      Wit: 8" B. Oak N49°30'W 81.1  
 Y. Pine 8" S32°E 13 lks      14 B. Oak S33°30'E 64.3  
 R. C. R. C. 5/8" bar in centerline  
 County Road.  
 8" B. Oak N49°30'W 81.1  
 14" B. Oak S33°30'E 64.3

Arleth 1976 Fd. 6" Lagscrew in Pav't Box 15.5 W. of Centerline of Murphy Rd. in centerline of County Rd #100. Set by MSHD  
 Arleth 1978 Fd 6" lagscrew  
 Wit same as 1976  
 Arleth 1986 Fd Lagscrew in Pav't Box - Wit same as 1976.

- B. Description of corner evidence found and/or method applied in restoring or reestablishing corner:

Corner and wit : destroyed by road construction 1996.  
 Corner reset from 1976, 1978 & 1986 Surveys made in this area by Arleth Land Survey Company.


**ROSCOMMON COUNTY  
PEER GROUP APPROVAL**

DATE NOV 8 1996

*Marvin E. Myers*  
 Marvin E. Myers, P.S.  
 County Surveyor

- C. Description of monument for corner and accessories established to perpetuate locating the position of the corner:

Set Roscommon County Standard Mon. in pav't Box. Stamped 21266 J-3  
 N & T in P. Pole N2°W 60.55  
 N & T in 18" W. Pine S51°E 76.45  
 Tel. sign post N45°E 98.20  
 N & T 12' Twn. R. Pine S18°W 52.53  
 1/2" bar N63°04'E 110.42  
 Carsonite Post S51°E 75.70

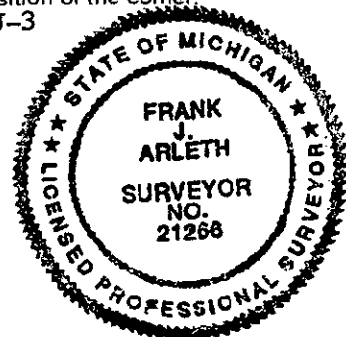

Signed by [Signature] Date 8 Nov 96

Surveyor's Michigan License No. \_\_\_\_\_ P. S. No. 21266

DATE: 8 Nov 96 PEER GROUP APPROVED

