


LAND CORNER RECORDATION CERTIFICATE
 Filing Requirement of Act 74, Mich P.A. 1970

For corners in
 Roscommon County

Located in: Corner Code #

1. Public Land Survey

T24N	R3W	J-7
T	R	
T	R	
T	R	

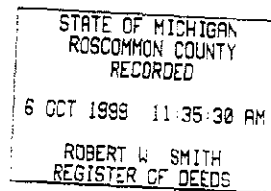

FILE IN LIBER 3 OF LAND CORNERS
 Register of Deeds Stamp & File Number

I, Larry L. Cavanagh, in a field survey September 9, 1999, do hereby certify that under requirements of P.A. 74, Michigan P.A. of 1970, the corner points mentioned in line 1 above was in conformance with regulations and rules therefore as required in the current manual of survey instructions of the United States Department of the Interior, Bureau of Land Management or by a decree of a Court of Law, established, re-established, monumented, recovered, found as expressed below:

	A	B	C	D	E	F	G	H	I	J	K	L	M
2	6	5	4	3	2	1							
3													
4	7	8	9	10	11	12							
5													
6	18	17	16	15	14	13							
7													
8	19	20	21	22	23	24							
9													
10	30	29	28	27	26	25							
11													
12	31	32	33	34	35	36							
13													

A. Description of original monument and accessories and/or subsequent restoration:

- | | |
|---|---|
| GLO, WILLIAM BURT 1852
SET 1/4 SEC. POST
WHITE PINE 8' S3°W 20 LKS
WHITE PINE 4' N6°E 16 LKS | FRANK J. ARLETH, PS 1993
L648, P583
MONUMENT MATERIAL NOT STATED
SAME WITNESSES AS ABOVE |
| LCRC 1970'S L2, P517
1/2" X 30" STEEL BAR
N8°W (PK) 156.2' 12" SPRUCE
N25°E (PK) 79.2' 15" OAK
S62°E (PK) 181.8' 18" NORWAY | LARRY L. CAVANAGH, PS 1993
SAME WITNESSES AS ABOVE
AND
SP IN P. POLE S33°W 41.9' |
| GEORGE D. HENNING, RLS 1979
L365 P443
FD 1/2" BAR
12" SPRUCE N8°W 156.2'
15" OAK N25°E 79.2'
18" R. PINE S62°E 181.8' | FARRIER SURVEYING 1996
L750, P462
FD 3/4" IRON IN MON BOX
N29°E 67.59' NAIL IN 20" OAK
S10°E 33.80' WOOD FENCE POST
S33°W 41.83' NAIL IN P. POLE
N32°W 42.24' NAIL IN P. POLE |
| FRANK J. ARLETH, RLS 1981
L401, P401
FD 1/2" BAR
SAME WITNESSES AS ABOVE | |

B. Description of corner evidence found and/or method applied in restoring or reestablishing corner:

- FOUND 5/8" X 20" RE-ROD IN PAV'T BOX
- FOUND ALL 1996 WITNESSES
- FOUND SPRUCE N8°W 156.2' 1979 12" (NOW 24")
- FOUND OAK N25°E 79.2' 1979 15" (NOW 23")

THE BEST AVAILABLE EVIDENCE OF THE POSITION OF THE ORIGINAL CORNER

C. Description of monument for corner and accessories established to perpetuate locating the position of the corner:


- SET STANDARD 3" X 21" ROSCOMMON COUNTY MONUMENT STAMPED 17614, IN PAV'T BOX
- WIT: NAIL & TAG IN FENCE POST S10°E 33.78"
- NAIL & TAG IN P. POLE S33°W 41.92' (1993)
- NAIL & TAG IN 20" BLACK OAK N29°E 67.65'
- NAIL & TAG IN P. POLE N32°W 42.41'
- CARSONITE POST S30°W 39.1'

**ROSCOMMON COUNTY
 PEER GROUP APPROVAL**

DATE Sept 10, 1999

Marvin E. Myers

Marvin E. Myers, P.S.
 County Surveyor

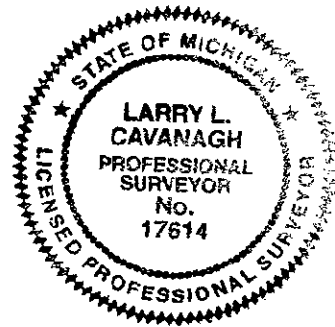

Signed by Larry L. Cavanagh
 Surveyor's Michigan License NO. 17614

Date Sept. 14, 1999

FORM APPROVED BY MICHIGAN STATE BOARD OF LAND SURVEYORS, JAN 28, 1971
 REVISED MAY 14, 1975
 REVISED JAN., 1983



LIBER 3

PAGE 609

SURVEY &
 RECORDATION

MAY 1 2000

SECTION