

**SURVEY &
REMONUMENTATION**

MAY 28 1997

COMMISSION

9600

LAND CORNER RECORDATION CERTIFICATE
Filing Requirement of Act 74, Mich. P.A. 1970

STATE OF MICHIGAN
ROSCOMMON COUNTY
RECORDED

For corners in

<u>ROSCOMMON</u> <small>(County)</small>	Located In:	Corner Code #
1. Public Land Survey	T <u>24</u> N R <u>3</u> W	<u>K-3</u>
	T _____ R _____	_____
	T _____ R _____	_____
	T _____ R _____	_____
2. Property Controlling in Section	S _____ T _____ R _____	_____
	S _____ T _____ R _____	_____
3. Miscellaneous Property in Sec.	S _____ T _____ R _____	_____
	S _____ T _____ R _____	_____
4. Lot No. _____, Recorded Plat _____		
5. Private Claims _____		

23 DEC 96 1:03 P.M.

ROBERT W. SMITH
REGISTER OF DEEDS

Register of Deeds Stamp & File Number

	A	B	C	D	E	F	G	H	I	J	K	L	M
2	6	5	4	3	2	1							
3													
4	7	8	9	10	11	12							
5													
6	16	17	18	15	14	13							
7													
8	19	20	21	22	23	24							
9													
10	30	29	28	27	26	25							
11													
12	31	32	33	34	35	36							
13													

I, FRANK J. ARLETH in a field survey on NOVEMBER 7, 19 96
do hereby certify that under requirements of P.A. 74, Michigan P.A. of 1970, the corner points mentioned in lines 1 and 2 above were in conformance with regulations and rules therefore as required in the current manual of survey instructions of the United States Department of the Interior, Bureau of Land Management or by a decree of a Court of Law and/or that the corner points mentioned in lines 3, 4 and 5 above were in conformance with the rules of the Michigan Board of Land Surveyors or by a Decree of a Court of Law; established, re-established, monumented, re-monumented, recovered, found as expressed below:

NOTE: Not more than 4 corners, all in the same town and range, may be recorded on this certificate.

A. Description of original monument and accessories and/or subsequent restoration:

WILLIAM BURT 1852
Y. PINE 14" N88°W, 61 LKS.
Y. PINE 8" N81°E, 50 LKS.

ARLETH 1976 FOUND 5/8" BAR
IN PAV'T. BOX
WIT. B. OAK 14" N38°E, 68.80'
WIT. R. OAK 12" S52°E, 51.40'

ROSCOMMON COUNTY ROAD COMM.
FOUND 5/8" BAR IN PAV'T. BOX
WIT. B. OAK 10" N38°E, 68.80'
WIT. R. OAK 8" S52°E, 51.40'

OSTLING 1946
SET 1/2" BOLT FOR CORNER
WIT. B. OAK 10" N38°E, 68.80'
WIT. R. OAK 8" S58°E, 51.40'

ARLETH 1978 FOUND 5/8" BAR
WITNESS SAME AS 1976.

ARLETH 1986 SAME WITNESS AS
1978.

COUNTRY CLUB ESTATES, 1981,
R, 7 OF PLATS, P, 45.

B. Description of corner evidence found and/or method applied in restoring or reestablishing corner:


FOUND 1/2" BOLT DEEP 5.0 SOUTH OF CENTERLINE OF COUNTY ROAD # 100
OLD WIT. B. OAK N38°E, 68.80'
OLD WIT. R. OAK S58°E, 51.40' GONE.

**ROSCOMMON COUNTY
PEER GROUP APPROVAL
DATE NOV 5 2011 1996**

Marvin E. Myers
**Marvin E. Myers, P.S.
County Surveyor**

C. Description of monument for corner and accessories established to perpetuate locating the position of the corner:

SET ROSCOMMON COUNTY STANDARD MONUMENT AND PAV'T. BOX 5.0 SOUTH OF CENTERLINE OF Co. Rd. #100
N & T POWER POLE S 7°E, 30.34'
N & T B. OAKE 14" S73°E, 86.53'
N & T W. PINE 10" N22°E, 62.03'
SE. CORNER OF 6' x 8' CONCRETE SLAB N16°W, 52.10'
1/2" BAR SOUTH, 33.10'
SET CARSONITE POST SOUTH, 33.10' AT 1/2" BAR

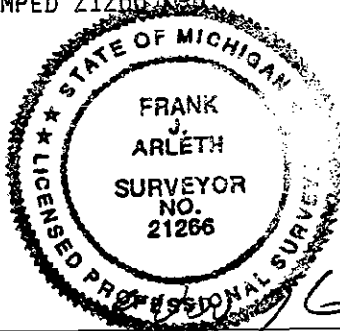

Signed by *Frank J. Arleth* Date _____
Surveyor's Michigan License No. 21266 P.S.