

LAND CORNER RECORDATION CERTIFICATE  
Filing Requirement of Act 74, Mich P.A. 1970

For corners in  
Roscommon County

Located in: Corner Code #

1. Public Land Survey

T24N R3W K-7  
T R  
T R  
T R

STATE OF MICHIGAN  
ROSCOMMON COUNTY  
RECORDED  
6 OCT 1999 11:35:32 AM  
ROBERT W. SMITH  
REGISTER OF DEEDS

I, Larry L. Cavanagh, in a field survey September 9, 1999, do hereby certify that under requirements of P.A. 74, Michigan P.A. of 1970, the corner points mentioned in line 1 above was in conformance with regulations and rules therefore as required in the current manual of survey instructions of the United States Department of the Interior, Bureau of Land Management or by a decree of a Court of Law; established, re-established, monumented, recovered, found as expressed below:

FILE IN LIBER 3 OF LAND CORNERS  
Register of Deeds Stamp & File Number

A. Description of original monument and accessories and/or subsequent restoration:

GLO, WILLIAM BURT 1852  
SET POST  
W. PINE 30° N60°W 56 LKS  
W. PINE 25° S63°E 45 LKS

LCRC 1980 L1, P147  
FRANK J. ARLETH, RLS  
2' PIPE  
SAME WITNESSES AS 1975

LCRC 1970 S 12, P516  
1" IRON PIPE  
S12°E (PK) 87.5' 10" R. PINE  
N60°W (PK) 72.6' 18" R. PINE  
N65°E (PK) 96.5' 18" P. PINE

FRANK J. ARLETH, RLS, 1981  
L401, P401  
PAV'T BOX IN BLACK TOP

FRANK J. ARLETH, RLS, 1975  
L308, P263  
FD 2" GAS PIPE  
SP IN 14' N. PINE N1°E 75.0'  
SP IN 16' N. PINE N45°W 72.0'

FRANK J. ARLETH, PS 1993  
L648, P583  
FD 2" PIPE  
SAME WITNESSES AS 1975

GEORGE D. HENNING, RLS 1979  
L365, P443  
FD 1" PIPE  
10" R. PINE S12°E 87.5'  
18" R. PINE N60°W 72.6'  
18" R. PINE N65°E 96.5'

LARRY L. CAVANAGH, PS, 1993  
NO MON MATERIAL CALLED OUT  
SP IN 14' N. PINE N1°E 75.0'  
SP IN 16' N. PINE N45°W 72.0'  
GAS PIPE LINE MARKER S28°E 64.05'  
1/2" BAR S45°W 46.70'

FARRIER SURVEYING, 1996 L750, P462  
FD 3/4" IRON BAR IN MON BOX  
WITNESSES SAME AS ABOVE

LCRC 1995 L1, P342  
CARL F. ROSER, RLS  
FD 3/4" IRON ROD IN MON BOX  
FD COR POST S41°E 44.67'  
FD COR. POST S44°W 43.35'  
UTILITY POLE N64°W 79.58'  
24" R. PINE N34°E 83.20'

	A	B	C	D	E	F	G	H	I	J	K	L	M
2	6	5	4	3	2	1							
3													
4	7	8	9	10	11	12							
5													
6	18	17	16	15	14	13							
7													
8	19	20	21	22	23	24							
9													
10	30	29	28	27	26	25							
11													
12	31	32	33	34	35	36							
13													

B. Description of corner evidence found and/or method applied in restoring or reestablishing corner:

FOUND 5/8" X 20" RE-ROD IN PAV'T BOX OVER 3/4" STEEL ROD (NOT REMOVED)  
FOUND ALL 1995 WITNESSES  
FOUND GAS PIPE LINE MARKER S28°E 64.05' 1993  
FOUND 1/2" CAPPED REROD S45°W 46.70' 1993  
FOUND N. PINE (NOW 21") N1°E MEASURED 75.0' TO CENTER OF TREE


THE BEST AVAILABLE EVIDENCE OF THE POSITION OF THE ORIGINAL CORNER.

C. Description of monument for corner and accessories established to perpetuate locating the position of the corner:

SET STANDARD 3" X 21" ROSCOMMON COUNTY MONUMENT STAMPED 17614, IN PAV'T BOX (OVER 3/4" STEEL ROD)  
WIT: NAIL & DNR TAG IN 24" N. PINE N34°E 83.16'  
NAIL & DNR TAG IN P. POLE N64°W 79.58'  
NAIL & DNR TAG IN FENCE POST S41°W 43.45'  
NAIL & DNR TAG IN FENCE POST S41°E 44.78'  
CARSONITE POST S48°W 43.0'

ROSCOMMON COUNTY  
PEER GROUP APPROVAL  
DATE Sept 10, 1999

*Marvin E. Myers MRM*  
Marvin E. Myers, P.S.  
County Surveyor

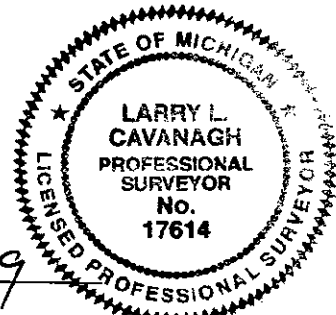

Signed by Larry L. Cavanagh  
Surveyor's Michigan License NO. 17614

Date Sept. 14, 1999

FORM APPROVED BY MICHIGAN STATE BOARD OF LAND SURVEYORS, JAN 28, 1971  
REVISED MAY 14, 1975  
REVISED JAN., 1983

SURVEY &  
RECORDS



LIBER 3

PAGE 611

SECTION