


LAND CORNER RECORDATION CERTIFICATE
Filing Requirement of Act 74, Mich P.A. 1970

For corners in
 Roscommon County

Located in: Corner Code #

1. Public Land Survey
 T24N R3W L-1
 T R
 T R
 T R

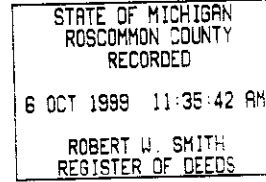

FILE IN LIBER 3 OF LAND CORNERS
 Register of Deeds Stamp & File Number

I, Larry L. Cavanagh, in a field survey July 1999, do hereby certify that under requirements of P.A. 74, Michigan P.A. of 1970, the corner points mentioned in line 1 above was in conformance with regulations and rules therefore as required in the current manual of survey instructions of the United States Department of the Interior, Bureau of Land Management or by a decree of a Court of Law; established, re-established, monumented, recovered, found as expressed below:

	A	B	C	D	E	F	G	H	I	J	K	L	M
2	6	5	4	3	2	1							
3													
4	7	8	9	10	11	12							
5													
6	18	17	16	15	14	13							
7													
8	19	20	21	22	23	24							
9													
10	30	29	28	27	26	25							
11													
12	31	32	33	34	35	36							
13													

A. Description of original monument and accessories and/or subsequent restoration:

JOHN BRINK, GLO 1838 SET QR SEC POST HEMLOCK 10° N13°W 27 LKS BEECH 7° S57°E 21 LKS	LARRY L. CAVANAGH PS, 1993 NO MON MATERIAL MENTIONED P. POLE S30°E 49.05' 16° R. PINE N20°E 88.2' 15° N. PINE N30°W 85.64' P. POLE S28°W 110.68'
HENNING & OSTLING 1945 IRON IN PAVT BOX 0.4' SOUTH OF CENTERLINE OF PAVT	FRANK J. ARLETH, PS 1996 L745, P109 PAVT BOX IN M-76 SAME WITNESSES AS L357, P505
GEORGE D. HENNING, RLS 1953 1/4 COR, MON BOX CENTERLINE OF PAVT.	LARRY L. CAVANAGH, PS 1997 SAME WITNESSES AS 1993 SURVEY
FRANK J. ARLETH, RLS, 1978 SURVEY L357, P505 MON BOX IN M-76 P. POLE S30°E 49.05' 16° R. PINE N20°E 88.2'	LARRY L. CAVANAGH PS 1998 SAME WITNESSES AS ABOVE

B. Description of corner evidence found and/or method applied in restoring or reestablishing corner:

FOUND PAVEMENT BOX OVER PAVEMENT BOX 1' BELOW THE SURFACE, ON CENTERLINE OF M-76 1'± EAST OF THE CENTERLINE OF STEEL ROAD
 NO MONUMENT IN BOX
 FOUND 15° N PINE NW
 FOUND 16° N PINE NE
 THE BEST AVAILABLE EVIDENCE OF THE POSITION OF THE ORIGINAL CORNER.


C. Description of monument for corner and accessories established to perpetuate locating the position of the corner:

SET 1/2 OF STANDARD MONUMENT CEMENTED IN PLACE OVER TOP OF BOTTOM MONUMENT BOX
 WIT: NAIL & TAG IN 17° N. PINE N20°E 88.63'
 NAIL & TAG IN 16° N PINE N30°W 85.57'
 NAIL & TAG IN P. POLE S23°W 110.59'
 NAIL & TAG IN LIGHT POLE S26°E 55.71'
 CARSONITE POST S50°W 56.7'

ROSCOMMON COUNTY
PEER GROUP APPROVAL

DATE Sept 10, 1999

Marvin E. Myers MRA
Marvin E. Myers, P.S.
 County Surveyor

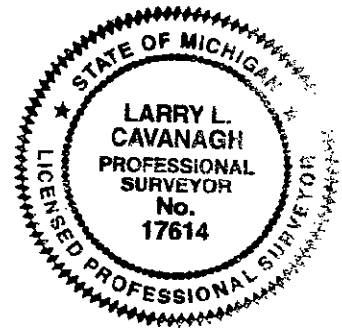

Signed by *Larry L. Cavanagh* Date Sept. 14, 1999
 Surveyor's Michigan License NO. 17614

FORM APPROVED BY MICHIGAN STATE BOARD OF LAND SURVEYORS, JAN 28, 1971
 REVISED MAY 14, 1975
 REVISED JAN., 1983



LIBER 3 PAGE 618

SURVEY & RECORDS

MAR 1 2000

SECTION