

**SURVEY &  
REMONUMENTATION**

MAY 28 1997

COMMISSION

0601

**LAND CORNER RECORDATION CERTIFICATE  
Filing Requirement of Act 74, Mich. P.A. 1970**

STATE OF MICHIGAN  
ROSCOMMON COUNTY  
RECORDED

23 DEC 96 1:03 P.M.

ROBERT W. SMITH  
REGISTER OF DEEDS

**Register of Deeds Stamp & File Number**

For corners in  
ROSCOMMON  
(County)

Located In: \_\_\_\_\_ Corner Code # \_\_\_\_\_

1. Public Land Survey	T <u>24</u> R <u>3</u> W	<u>L-3</u>
	T _____ R _____	_____
	T _____ R _____	_____
	T _____ R _____	_____
2. Property Controlling in Section	S _____ T _____ R _____	_____
	S _____ T _____ R _____	_____
3. Miscellaneous Property in Sec.	S _____ T _____ R _____	_____
	S _____ T _____ R _____	_____
4. Lot No. _____, Recorded Plat _____		
5. Private Claims _____		

	A	B	C	D	E	F	G	H	I	J	K	L	M
2	6	5	4	3	2	1							
3													
4	7	8	9	10	11	12							
5													
6	18	17	16	15	14	13							
7													
8	19	20	21	22	23	24							
9													
10	30	29	28	27	26	25							
11													
12	31	32	33	34	35	36							
13													

I, FRANK J. ARLETH, in a field survey on NOVEMBER 5, 1996, do hereby certify that under requirements of P.A. 74, Michigan P.A. of 1970, the corner points mentioned in lines 1 and 2 above were in conformance with regulations and rules therefore as required in the current manual of survey instructions of the United States Department of the Interior, Bureau of Land Management or by a decree of a Court of Law and/or that the corner points mentioned in lines 3, 4 and 5 above were in conformance with the rules of the Michigan Board of Land Surveyors or by a Decree of a Court of Law; established, re-established, monumented, re-monumented, recovered, found as expressed below:

**NOTE: Not more than 4 corners, all in the same town and range, may be recorded on this certificate.**

**A. Description of original monument and accessories and/or subsequent restoration:**

WILLIAM BURT 1852	OSTLING 1972
Y. PINE 18" N80°W, 4.10 LKS.	FOUND 5/8" BAR
HENNING 1948 FOUND 3/4" IRON BAR	WIT. B. OAK 16" N22°E, 73.50'
B.T. B. OAK 16" N22°E, 73.50'	WIT. B. OAK 14" S40½°E, 44.40'
B.T. B. OAK 14" S40½°E, 44.40'	OSTLING 1973 SAME AS 1972
	ARLETH 1977
	FOUND 5/8" BAR
	WIT. SAME AS OSTLING 1973

ROSCOMMON Co. Rd. Comm.  
FOUND 5/8" IRON BAR IN  
PAV'T. BOX CENTERLINE OF RD  
WIT. 16" OAK N22°E, 73.50'  
WIT. 14" OAK S40°E, 44.40'  
ARLETH 1990  
FOUND 3/4" BAR WITNESS  
SAME AS 1977.

**B. Description of corner evidence found and/or method applied in restoring or reestablishing corner:**

FOUND 3/4" IRON BAR IN CENTERLINE OF COUNTY ROAD # 100 AND STEELE ROAD  
OLD WIT. 14" B. OAK S40½°E, 44.40' (STP.)  
OLD WIT. 18" B. OAK N22°E, 73.50' (GONE)


**ROSCOMMON COUNTY  
PEER GROUP APPROVAL  
DATE NOV 3 1996**

*Marvin E. Myers*  
**Marvin E. Myers, P.S.  
County Surveyor**

**C. Description of monument for corner and accessories established to perpetuate locating the position of the corner:**

SET ROSCOMMON COUNTY STANDARD MONUMENT AND PAV'T. BOX  
N & T POWER POLE N38°W, 44.55'  
N & T POWER POLE S37°E, 36.10'  
N & T 12" B. OAK S 8°E, 56.12'  
N & T POWER POLE S51°W, 44.35'  
SET CARSONITE POST S37°E, 35.70'

STAMPED 21266

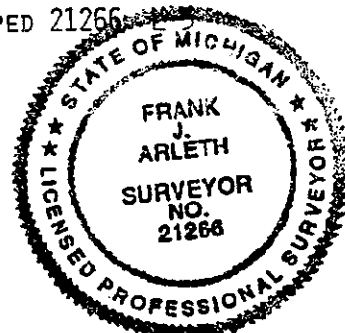

Signed by *Frank J. Arleth*  
Surveyor's Michigan License No. 21266 P.S.

Date 8 Nov 96

DATE: 8 Nov 96, PEER GROUP APPROVED. LIBER 3 PAGE 38.