

LAND CORNER RECORDATION CERTIFICATE
Filing Requirement of Act 74, Mich. P.A. 1970

STATE OF MICHIGAN
 ROSCOMMON COUNTY
 RECORDED
 (6 MAY 99 2:09 P.M.)
 6 MAY 99 2:09 P.M.

For corners in

<u>Roscommon</u> (County)	Located In:	Corner Code #
1. Public Land Survey	T <u>24N</u> R <u>2W</u>	<u>A-1</u>
	T <u>24N</u> R <u>3W</u>	<u>M-1</u>
	T _____ R _____	_____
	T _____ R _____	_____
2. Property Controlling in Section	S _____ T _____ R _____	_____
	S _____ T _____ R _____	_____
3. Miscellaneous Property in Sec.	S _____ T _____ R _____	_____
	S _____ T _____ R _____	_____

ROBERT W. SMITH
 REGISTER OF DEEDS

To be filed in Liber 3 of Land Corners
Register of Deeds Stamp & File Number

4. Lot No. _____, Recorded Plat _____
 5. Private Claims _____

I, Marvin E. Myers, in a field survey on March, 1999 do hereby state that under requirements of P.A. 74, Michigan P.A. of 1970, the corner points mentioned in lines 1 and 2 above were in conformance with regulations and rules therefore as required in the current manual of survey instructions of the United States Department of the Interior, Bureau of Land Management or by a decree of a Court of Law and /or that the corner points mentioned in lines 3, 4 and 5 above were in conformance with the rules of the Michigan Board of Land Surveyors or by a Decree of a Court of Law; established, re-established, monumented, recovered, found as expressed below:

1	A	B	C	D	E	F	G	H	I	J	K	L	M
2	6		5		4		3		2		1		
3													
4	7		8		9		10		11		12		
5													
6	18		17		16		15		14		13		
7													
8	19		20		21		22		23		24		
9													
10	30		29		28		27		26		25		
11													
12	31		32		33		34		35		36		
13													

NOTE: Not more than 2 corners, all in the same town and range, may be recorded on this certificate.

A. Description of original monument and accessories and/or subsequent restoration:

G.L.O. - 1838 John Brink D.S. Mon. - Post 9" Birch S38 1/2°E 16 links. 14" Cedar N73°W 15 links	George D. Henning R.L.S. Unrecorded survey December 1941 Mon: 1 1/4" pipe in Fence line, verified by the stumps of the ORIGINAL US BTs. Wit: 3" Cedar S54°W 35.61' 5" Cedar north 28.4' 6" Cedar S71°E 28.7' 4" Cedar N53°W 25.5'	Plat of Northwest Village Ostling Surveys, INC. Mon: No description provided Wit: Witness Mon. S01°53'W 1.0'	C. Eugene Ostling R.L.S. #12026 LCRC Liber 1, Page 11, dated 1971 Mon: 3/4" pipe Wit: Spike in P.P. S89°E 11.8' Spike in 4" Maple S70°W 31.25
George D. Henning R.L.S. Unrecorded survey February 1942 Mon: 2" Gas Pipe Wit: 3" Cedar S54°W 54 links 5" Cedar North 44 1/2 links 6" Cedar S71°E 43 1/2 links 4" Cedar N53°W 38 1/2 links	George D. Henning R.L.S. #2240 Mon: 3/4" pipe in corner Wit: P. Pole S89°E 11.9' 4" Maple S70°W 31.25'	Norman F. Parker R.L.S.#16939 Mon: concrete monument Wit: none provided	Larry L. Cavanagh R.L.S. 17614 Mon: no description provided Wit: Spike in P. Pole S30°E 49.00' Spike in 16" Red Pine N20°E 8.0'


B. Description of corner evidence found and/or method applied in restoring or reestablishing corner:

Found 1 1/4" pipe set in a railroad tie fence post in the intersection of fences North, South, East and West; verified location from Henning witness's.
 Found 5" Cedar North 29.4' Found 6" Cedar Stump S71°E 28.7' Found 4" Cedar N53°W 25.5'
 Found Witness Monument pulled out lying 1.4' South of the corner
 Accepted 1 1/4" pipe as a perpetuation of the Original Government Corner. Replaced pipe with Standard Roscommon County monument.

C. Description of monument for corner and accessories established to perpetuate locating the position of the corner:

Mon: Standard Roscommon County Corner in the intersection of North - South & East - West Fences
 Wit: Set Carsonite Post West 0.5'
 Set nail & tag in 14" blazed Cedar (previously 4") N53°W 25.95'
 Set nail & tag in 12" Cedar N06°E 26.44'
 Set nail & tag in utility pole S74°E 12.20'

Signed by Marvin E. Myers
 Surveyor's Michigan License No. 31699
 ROSCOMMON COUNTY

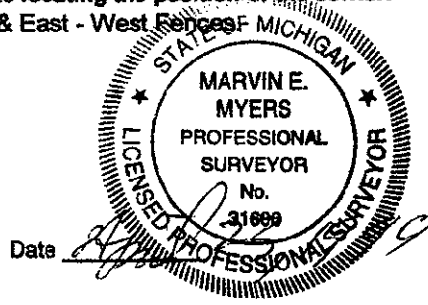

PEER GROUP APPROVAL
 DATE April 19, 1999
Marvin E. Myers
 Marvin E. Myers, P.S.
 County Surveyor

FORM APPROVED BY MICHIGAN STATE BOARD OF PROFESSIONAL SURVEYORS, JAN. 28, 1971
 REVISED MAY 14, 1975
 REVISED JAN., 1983
 REVISED OCT., 1985

LIBER 3 PAGE 595