

LAND CORNER RECORDATION CERTIFICATE
Filing Requirement of Act 74, Mich. P.A. 1970

STATE OF MICHIGAN
 ROSCOMMON COUNTY
 RECORDED

For corners in

Roscommon
 (County)

Located In:

Corner Code #

1. Public Land Survey

T 24N R 2W
 T 24N R 3W
 T _____ R _____
 T _____ R _____

A-8
M-8

2. Property Controlling in Section

S _____ T _____ R _____
 S _____ T _____ R _____
 S _____ T _____ R _____
 S _____ T _____ R _____

3. Miscellaneous Property in Sec.

4. Lot No. _____, Recorded Plat _____
 5. Private Claims _____

6 MAY 99 2:08 P.M.

ROBERT W. SMITH
 REGISTER OF DEEDS

To be filed in Liber 3 of Land
 Register of Deeds Stamp & File Number

I, Marvin E. Myers, in a field survey on March, 1999 do hereby state that under requirements of P.A. 74, Michigan P.A. of 1970, the corner points mentioned in lines 1 and 2 above were in conformance with regulations and rules therefore as required in the current manual of survey instructions of the United States Department of the Interior, Bureau of Land Management or by a decree of a Court of Law and /or that the corner points mentioned in lines 3, 4 and 5 above were in conformance with the rules of the Michigan Board of Land Surveyors or by a Decree of a Court of Law, established, re-established, monumented, recovered, found as expressed below:

	A	B	C	D	E	F	G	H	I	J	K	L	M
1													
2	6		5		4		3		2		1		
3													
4	7		8		9		10		11		12		
5													
6	18		17		16		15		14		13		
7													
8	19		20		21		22		23		24		
9													
10	30		29		28		27		26		25		
11													
12	31		32		33		34		35		36		
13													

NOTE: Not more than 2 corners, all in the same town and range, may be recorded on this certificate.

A. Description of original monument and accessories and/or subsequent restoration:

G.L.O - 1838
 John Brink D.S.
 Mon. - Post
 Wit: 8" Spruce Pine N10°E 10 links
 8" Spruce Pine S42°W 6 links

Roscommon County Records
 Liber 2, Page 527
 Mon: 1/2" Bar
 Wit: 30" Oak S30°W 54.0'
 36" Oak N50°W 70.2'

DNR June 4, 1997 C. Kiiskila, P.S.
 Mon - DNR monument
 Wit: Center of N-S trail is 10' East

B. Description of corner evidence found and/or method applied in restoring or reestablishing corner:

Found Michigan Department of Natural Resources pipe and cap stamped as E. 1/4 corner of Section 24, T24N, R3W.
 Found Spike NW face 10" White Pine S26°W 9.03' Found Spike in West face 10" (dead) Jack Pine South 3.21'
 Found D.N.R. Carsonite Post West 1.4' Found Spike in East face 10" Jack Pine N03°E 14.38'
 Found Spike in North face 6" Stump S68°E 21.75'
 Accepted DNR monument as the best available evidence of the position of the Original Corner. Left DNR capped Iron and post in place.

C. Description of monument for corner and accessories established to perpetuate locating the position of the corner:

Mon: D.N.R. capped iron and post in place.
 Wit: Spike NW face 10" White Pine S26°W 9.03'
 D.N.R. Carsonite Post West 1.4'
 Spike in North face 6" Stump S68°E 21.75'


Spike in West face 10" (dead) Jack Pine South 3.21'
 Spike in East face 10" Jack Pine N03°E 14.38'
 Set nail & tag in SE face 3" Maple

**ROSCOMMON COUNTY
 PEER GROUP APPROVAL**

DATE April 19, 1999

Marvin E. Myers

Marvin E. Myers, P.S.
 County Surveyor

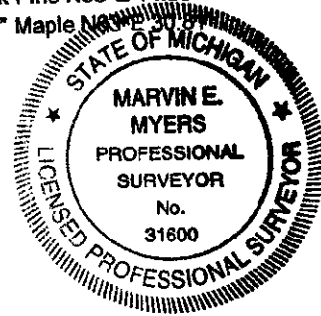

Signed by

Marvin E. Myers

Date

May 04, 1999

Surveyor's Michigan License No. 31600