

OCT 19 1998

6043

LAND CORNER RECORDATION CERTIFICATE SECTION
Filing Requirement of Act 74, Mich. P.A. 1970

STATE OF MICHIGAN
ROSCOMMON COUNTY
RECORDED

20 JUL 98 8:31 A.M.

ROBERT W. SMITH
REGISTER OF DEEDS

FILED IN LIBER 3 OF LAND CORNER
Register of Deeds Stamp & File Number

For corners in

Roscommon (County)	Located In:	Corner Code #
1. Public Land Survey	T 24N R 3W	M-11 ✓
	T 24N R 2W	A-11
2. Property Controlling in Section	S T R	
	S T R	
3. Miscellaneous Property in Sec.	S T R	
	S T R	

4. Lot No. _____, Recorded Plat _____

5. Private Claims _____

I, Carl T. Kiiskila, in a field survey on April 24, 1998 do hereby state that under requirements of P.A. 74, Michigan P.A. of 1970, the corner points mentioned in lines 1 and 2 above were in conformance with regulations and rules therefore as required in the current manual of survey instructions of the United States Department of the Interior, Bureau of Land Management or by a decree of a Court of Law and /or that the corner points mentioned in lines 3, 4 and 5 above were in conformance with the rules of the Michigan Board of Land Surveyors or by a Decree of a Court of Law; established, re-established, monumented, recovered, found as expressed below:

NOTE: Not more than 2 corners, all in the same town and range, may be recorded on this certificate.

A. Description of original monument and accessories and/or subsequent restoration:

M-11 GLO - set section post - Wm. Burt - 1852
Witness: 11" Hemlock S 33.5° W 29 links
8" Birch N 49° W 15 links

N. Caldwell - January 1966 - found 3/4" bar in monument box 10" below pavement, MDOT raised with 1 1/4" pipe.
Witness: 12" Jack Pine N 65° W 38.52'
9" Jack Pine S 60° W 57.85'
24" Jack Pine N 45° E 70.52'
12" Twin Oak S 50° E 90.00'


Liber 1, Page 302 - August 16, 1991 - M. Myers found 1 1/4" pipe.
Witness: 12" Jack Pine nail & tag S 60° W 57.85'
14" Jack Pine N 65° W 38.51'
28" Norway Pine nail & tag N 45° E 70.52'
16" Twin Oak S 50° E 90.92'
Center bit East 5.5' ±

B. Description of corner evidence found and/or method applied in restoring or reestablishing corner:

M-11 Found 1 1/4" pipe driven over 3/4" bar in an old monument box 12" below pavement grade, fitting M. Myers' witnesses above. Accepted 3/4" bar as best evidence of the position of the original corner. Replaced the 3/4" bar with standard Roscommon County monument.

C. Description of monument for corner and accessories established to perpetuate locating the position of the corner:

M-11 Monument - set standard Roscommon County monument in pavement box 6' west of the center of north-south road.
Witness: Set nail & tag in NW side 30" Red Pine N 51° E 70.49'
Set nail & tag in SW side 12" and 18" Twin Oak S 41° E 90.89'
Set nail & tag in NW side 12" Jack Pine S 39° W 77.38'
Set nail & tag in NE side 14" Jack Pine N 55° W 38.48'

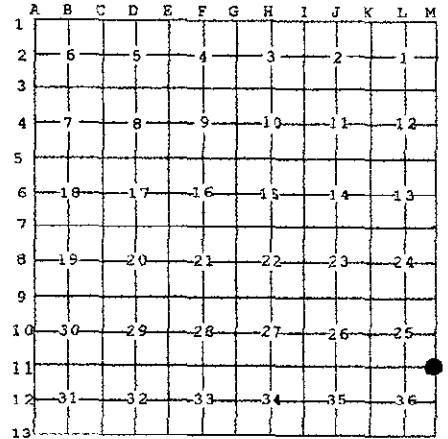

Signed by

Carl T. Kiiskila

Date

7-14-98

Surveyor's Michigan License No. 33981

ROSCOMMON COUNTY

PEER GROUP APPROVAL

DATE MAY 15th 1998

Marvin E. Myers

Marvin E. Myers, P.S.
County Surveyor

FORM APPROVED BY MICHIGAN STATE BOARD OF PROFESSIONAL SURVEYORS, JAN. 28, 1971
REVISED MAY 14, 1975
REVISED JAN., 1993
REVISED OCT., 1995

1, 0, 0, 0 3 PAGE 540