

LAND CORNER RECORDATION CERTIFICATE
Filing Requirement of Act 74, Mich. P.A. 1970

STATE OF MICHIGAN
ROSCOMMON COUNTY
RECORDED

For corners in

<u>Roscommon</u> (County)	Located In:	Corner Code #
1. Public Land Survey	T <u>24N</u> R <u>4W</u>	<u>F-1</u>
	T _____ R _____	_____
	T _____ R _____	_____
	T _____ R _____	_____
2. Property Controlling in Section	S _____ T _____ R _____	_____
	S _____ T _____ R _____	_____
3. Miscellaneous Property in Sec.	S _____ T _____ R _____	_____
	S _____ T _____ R _____	_____

8 JUN 99 3:51 P.M.

ROBERT W. SMITH
REGISTER OF DEEDS

FILE IN LIBER 3 OF LAND CORNERS
Register of Deeds Stamp & File Number

4. Lot No. _____, Recorded Plat _____
5. Private Claims _____

I, Marvin E. Myers, in a field survey on April, 1999, do hereby state that under requirements of P.A. 74, Michigan P.A. of 1970, the corner points mentioned in lines 1 and 2 above were in conformance with regulations and rules therefore as required in the current manual of survey instructions of the United States Department of the Interior, Bureau of Land Management or by a decree of a Court of Law and /or that the corner points mentioned in lines 3, 4 and 5 above were in conformance with the rules of the Michigan Board of Land Surveyors or by a Decree of a Court of Law; established, re-established, monumented, recovered, found as expressed below:

	A	B	C	D	E	F	G	H	I	J	K	L	M
1													
2	6			5		4		3		2		1	
3													
4	7			8		9		10		11		12	
5													
6	18			17		16		15		14		13	
7													
8	19			20		21		22		23		24	
9													
10	30			29		28		27		26		25	
11													
12	31			32		33		34		35		36	
13													

NOTE: Not more than 2 corners, all in the same town and range, may be recorded on this certificate.

A. Description of original monument and accessories and/or subsequent restoration:


- G.L.O - 1839 John Brink, D.S. Mon - Post Wit: 10" Pitch Pine N70°E 52 lks. 7" Pitch Pine N61°W 26 lks.
- Marcus Schaaf 1940's Mon - Iron Set
- L1, P ? LCRC K. Ostling, RLS Dec 1979 Mon - Found Schaaf 2" Pipe left in place Wit: 8" R. Pine N51°E 190.00 7" W. Oak N71°W 158.26 Cedar Post South 30.00

B. Description of corner evidence found and/or method applied in restoring or reestablishing corner:
Found 2" pipe Schaaf Monument 1.0 below surface in fire lane N-S, & E-W; found DNR post South lying flat; found 15" W. Oak N71°W 158.26 Accepted 2" pipe as the best available evidence of the position of the Original Corner. Replaced pipe with standard Crawford County monument.

C. Description of monument for corner and accessories established to perpetuate locating the position of the corner:
Mon: Standard Crawford County Monument.
Wit: 15" W. Oak N71°W 158.26
Nail & tag in W. side 8" J. Pine N12°W 37.85
Nail & tag 4" R. Pine N43°E 41.52
Nail & tag 4" J. Pine S41°W 39.30

ROSCOMMON COUNTY
PEER GROUP APPROVAL
DATE April 19, 1999

Marvin E. Myers MREA
Marvin E. Myers, P.S.
County Surveyor

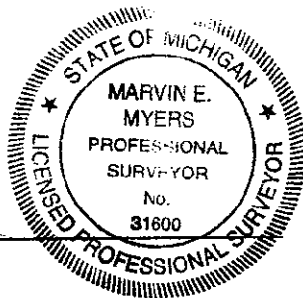

Signed by *Marvin E. Myers*
Surveyor's Michigan License No. 31600

Date June 2, 1999

FORM APPROVED BY MICHIGAN STATE BOARD OF PROFESSIONAL SURVEYORS, JAN. 28, 1971
REVISED MAY 14, 1975
REVISED JAN., 1983
REVISED OCT., 1985

LIBER 3 PAGE 605

SURVEY &
RECORDATION

MAR 01 2000

SECTION