

5087

JAN 24 1996

LAND CORNER RECORDATION CERTIFICATE
Filing Requirement of Act 74, Mich. P.A. 1970

For corners in Roscommon (County) Located In: Corner Code #

- 1. Public Land Survey T 24N R 4W H - 8
2. Property Controlling in Section S T R
3. Miscellaneous Property in Section S T R
4. Lot No. Recorded Plat
5. Private Claims

STATE OF MICHIGAN
ROSCOMMON COUNTY
RECORDED

14 AUG 95 3:47 P.M.

ROBERT W. SMITH
REGISTER OF DEEDS

To be filed in Liber 3 of Land Corners

Register of Deeds Stamp & File Number

APR 05 1996

COMMISSION

I, Marvin E. Myers, in a field survey on July 17, 1995, do hereby certify that under requirements of P.A. 74, Michigan P.A. of 1970, the corner points mentioned in lines 1 and 2 above were in conformance with regulations and rules therefore as required in the current manual of survey instructions of the United States Department of the Interior, Bureau of Land Management or by a decree of a Court of Law and/or that the corner points mentioned in lines 3, 4 and 5 above were in conformance with the rules of the Michigan Board of Professional Surveyors or by a Decree of a Court of Law; established, re-established, monumented, re-monumented, recovered, found as expressed below:

NOTE: Not more than 4 corners, all in the same town and range, may be recorded on this certificate.

Grid table with columns A-L and rows 1-13. Cell (8, H) contains a circled '6'.

A. Description of original monument and accessories and/or subsequent restoration:

- C.E. Ostling Aug. 29, 1968 Mon-1/2"x18" Bar WIT: 1/2" Bar NE 46.28'
C.E. Ostling Sept. 26, 1968 Mon-1/2"x18" Steel Bar WIT: 14" W.Oak N47°W 65.00' 12" W.Oak S82 1/2°W 75.10'
C.E. Ostling Sept. 4, 1969 L.6, pg.41 ARROWHEAD HILLS Mon-1/2"x18" Bar WIT: Conc. Mon. NE 46.28'
L.L. Cavanagh LCRC L.1, pg.18 Mon-Conc. Mon. (ARROWHEAD HILLS)
L.2, pg.561 Mon-Conc. Mon. WIT: 1/2" Bar South 33.00' 1/2" Bar West 33.00'

B. Description of corner evidence found and/or method applied in restoring or reestablishing corner:


Found concrete monument top broken. Found 12" (now 16") blazed white oak with small nail in side at record distance.

ROSCOMMON COUNTY
PEER GROUP APPROVAL
DATE AUG 8th, 1995

Marvin E. Myers, P.S.
County Surveyor

C. Description of monument for corner and accessories established to perpetuate locating the position of the corner:

- Mon-Standard Roscommon County Monument
WIT: Set nail & tag S. face 7" W.Oak N78°E 7.29'
E. edge of carsonite post S17°W 0.9'
Fd. 1/2" bar S08°W 33.27'
PK In N. side utility pole S62°W 37.65'
Fd. blazed & nail 16" oak S83°W 75.10'
Fd. nail in N. face light pole N72°W 55.44'
Fd. Conc. Mon. N54°E 46.28'
H-8 to G-8 = N89°20'16"W 2653.95'
H-8 to I-8 = S89°19'49"E 2637.80'
H-8 to H-7 = N01°37'48"E 2629.15'
H-8 to H-9 = S01°40'08"W 2624.08'

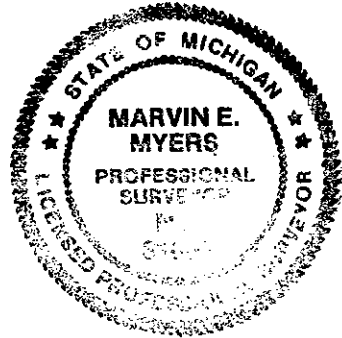

Signed by Marvin E. Myers Date AUGUST 9, 1995

Surveyor's Michigan License No. 31600 FORM APPROVED BY MICHIGAN STATE BOARD OF PROFESSIONAL SURVEYORS, JAN. 28, 1971 REVISED MAY 14, 1975 REVISED JAN. 1983