

5086

JAN 24 1996

COMMISSION CORNER RECORDATION CERTIFICATE

Filing Requirement of Act 74, Mich. P.A. 1970

For corners in Roscommon (County) Located In: Corner Code #

1. Public Land Survey T 24N R 4W J - 7  
 T R  
 T R  
 T R

2. Property Controlling in Section S T R  
 S T R  
 S T R

3. Miscellaneous Property in Section S T R  
 S T R

4. Lot No. \_\_\_\_\_, Recorded Plat \_\_\_\_\_

5. Private Claims \_\_\_\_\_

To be filed in liber 3 of Land Corner

STATE OF MICHIGAN  
 ROSCOMMON COUNTY  
 RECORDED

14 AUG 95 3:47 P.M.

ROBERT W. SMITH  
 REGISTER OF DEEDS

APR 05 1996  
 COMMISSION

A	B	C	D	E	F	G	H	I	J	K	L	M
2	6	5	4	3	2							
3												
4	7	8	9	10	11	12						
5												
6	18	17	16	15	14	13						
7												
8	19	20	21	22	23	24						
9												
10	30	29	28	27	26	25						
11												
12	31	32	33	34	35	36						
13												

I, Marvin E. Myers, in a field survey on July 17, 1995, do hereby certify that under requirements of P.A. 74, Michigan P.A. of 1970, the corner points mentioned in lines 1 and 2 above were in conformance with regulations and rules therefore as required in the current manual of survey instructions of the United States Department of the Interior, Bureau of Land Management or by a decree of a Court of Law and/or that the corner points mentioned in lines 3, 4 and 5 above were in conformance with the rules of the Michigan Board of Professional Surveyors or by a Decree of a Court of Law; established, re-established, monumented, re-monumented, recovered, found as expressed below:

NOTE: Not more than 4 corners, all in the same town and range, may be recorded on this certificate.

A. Description of original monument and accessories and/or subsequent restoration:

GLO-A.P. Brewer Oct. 1852	L.2, pg.50 HIGGINS LAKE SHORES	G.D. Henning Dec. 15, 1953
Mon-Post	Dec. 15, 1941 James E. Richardson	Mon-Conc. Mon.
WIT: 18" Y.Pine N77°W 10 lks.	Mon-Unknown	WIT: None Given
14" W.Pine S68°E 39 lks.	WIT: Conc. Mon. East 60.00'	
	Conc. Mon. North 52.07'	

B. Description of corner evidence found and/or method applied in restoring or reestablishing corner:


Found concrete monument. Found 1/2" ID x 13 1/2" pipe along side.

ROSCOMMON COUNTY  
 PEER GROUP APPROVAL  
 DATE AUG 8, 1995

*Marvin E. Myers*  
 Marvin E. Myers, P.S.  
 County Surveyor

C. Description of monument for corner and accessories established to perpetuate locating the position of the corner:

Mon-Std. Roscommon County Mon. centerline County Rd. #200 North 17.60'±  
 WIT: Carsonite Post N06°W 49.64' to West edge  
 Fd. conc. mon. N05°E 52.07'  
 Fd. conc. mon. S86°E 60.46'  
 Fd. conc. mon. S05°W 17.21'  
 Fd. nail E. side Guy Pole S03°W 11.13'  
 Fd. blaze set Nail & Tag NW face 11" R.Oak S52°W 57.93'

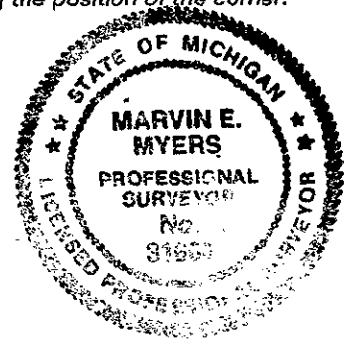

Signed by *Marvin E. Myers*  
 Surveyor's Michigan License No. 31600

Date AUG 9, 1995