

5083

JAN 24 1996

LAND CORNER RECORDATION CERTIFICATE
Filing Requirement of Act 74, Mich. P.A. 1970

For corners in

Roscommon (County)

Located In:

Corner Code #

- 1. Public Land Survey T 24N R 4W J - 9
T _____ R _____
T _____ R _____
T _____ R _____
- 2. Property Controlling S _____ T _____ R _____
in Section S _____ T _____ R _____
- 3. Miscellaneous S _____ T _____ R _____
Property in Section S _____ T _____ R _____
- 4. Lot No. _____, Recorded Plat _____
- 5. Private Claims _____

APR 05 1996

COMMISSION

To be filed in liber 3 of Land Corne

STATE OF MICHIGAN
ROSCOMMON COUNTY
RECORDED

14 AUG 95 3:47 P.M.

Register of Deeds Stamp & File Number
ROBERT W. SMITH
REGISTER OF DEEDS

I, Marvin E. Myers, in a field survey on July 10, 19 95, do hereby certify that under requirements of P.A. 74, Michigan P.A. of 1970, the corner points mentioned in lines 1 and 2 above were in conformance with regulations and rules therefore as required in the current manual of survey instructions of the United States Department of the Interior, Bureau of Land Management or by a decree of a Court of Law and/or that the corner points mentioned in lines 3, 4 and 5 above were in conformance with the rules of the Michigan Board of Professional Surveyors or by a Decree of a Court of Law; established, re-established, monumented, re-monumented, recovered, found as expressed below:

NOTE: Not more than 4 corners, all in the same town and range, may be recorded on this certificate.

A. Description of original monument and accessories and/or subsequent restoration:

- CLO-A.P. Brewer 1852 L.2, pg.565 LCRC
Mon-Post Mon-1/2" Bar
WIT: 10" Y.Pine N70°W 20 lks. WIT: 14" W.Oak N27°W 32.70'
8" S.Pine S81°E 23 lks. 12" R.Oak S44°W 63.00'
- G.D. Henning Oct. 7, 1954 F.J. Arleth June 1978 L.1, pg.151
Mon-None given Mon-1/2" Bar
WIT: None given WIT: 14" W.Oak N27°W 32.70'
12" R.Oak S44°W 63.00'

B. Description of corner evidence found and/or method applied in restoring or reestablishing corner:

Found 12" cabin spike at depth of 3 feet.
Found rotting wood stake below spike under old road bed


C. Description of monument for corner and accessories established to perpetuate locating the position of the corner:

- Mon-Std. Roscommon County Mon. set
WIT: Fd. spike E. face 15" R.Oak N12°E 16.80'
Fd. spike N. face Power Pole S60°E 105.35'
Fd. nail NE side at 57.96' (nail in poor condition) set nail & tag N. face 15" W.Oak S56°W 58.45'
Set nail & tag E. face 6" R.Oak S07°E 22.72'
Set carsonite post S04°W 33'±

	A	B	C	D	E	F	G	H	I	J	K	L	M
2	6		5		4		3		2		1		
3													
4	7		8		9		10		11		12		
5													
6	18		17		16		15		14		13		
7													
8	19		20		21		22		23		24		
9													
10	30		29		28		27		26		25		
11													
12	31		32		33		34		35		36		
13													

ROSCOMMON COUNTY
PEER GROUP APPROVAL
DATE AUGUST 8th 1995

Marvin E. Myers
Marvin E. Myers, P.S.
County Surveyor

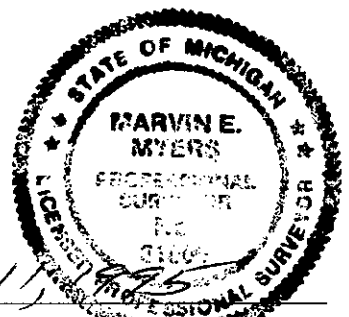

Signed by Marvin E. Myers
Surveyor's Michigan License No. 31600

Date AUG 11, 1995

FORM APPROVED BY MICHIGAN STATE BOARD OF PROFESSIONAL SURVEYORS, JAN. 28, 1971
REVISED MAY 14, 1975
REVISED JAN., 1983

LIBER 3 PAGE 234