

FEB 18 1994

ROSCOMMON COUNTY REMONUMENTATION

9230 COMMISSION

LAND CORNER RECORDATION CERTIFICATE
Filing Requirement of Act 74, Mich. P.A. 1970

DEC 28 10 27 AM '93

For corners in

Roscommon (County)	Located In:	Corner Code #
1. Public Land Survey	T <u>24N</u> R <u>4W</u>	<u>K - 10</u>
	T _____ R _____	_____
	T _____ R _____	_____
	T _____ R _____	_____
2. Property Controlling in Section	S _____ T _____ R _____	_____
	S _____ T _____ R _____	_____
3. Miscellaneous Property in Sec.	S _____ T _____ R _____	_____
	S _____ T _____ R _____	_____
4. Lot No. _____, Recorded Plat _____		
5. Private Claims _____		

Robert J. ...
REGISTERED

ROSCOMMON COUNTY
PEER GROUP APPROVAL
DATE 12-14-93

Register of Deeds Stamp & File Number

I, Marvin E. Myers, in a field survey on Dec, 19 93, do hereby certify that under requirements of P.A. 74, Michigan P.A. of 1970, the corner points mentioned in lines 1 and 2 above were in conformance with regulations and rules therefore as required in the current manual of survey instructions of the United States Department of the Interior, Bureau of Land Management or by a decree of a Court of Law and/or that the corner points mentioned in lines 3, 4 and 5 above were in conformance with the rules of the Michigan Board of Land Surveyors or by a Decree of a Court of Law; established, re-established, monumented, re-monumented, recovered, found as expressed below:

A	B	C	D	E	F	G	H	I	J	K	L	M
2	6	5	4	3	2	1						
3												
4	7	8	9	10	11	12						
5												
6	18	17	16	15	14	13						
7												
8	19	20	21	22	23	24						
9												
10	30	29	28	27	26	25						
11												
12	31	32	33	34	35	36						
13												

NOTE: Not more than 4 corners, all in the same town and range, may be recorded on this certificate.

A. Description of original monument and accessories and/or subsequent restoration:

GLO - Aug. 1852 A. Brewer	June 1964 G. Henning	Wildwood Park L.6, pg.68 G. Henning June 1970
Mon. - Post	MON- Not Given	Mon. - Not Given
WIT: 15" Y. Pine n32°E 29 lks. 16" Y. Pine S48°W 52 lks.	Wit- Not given	WIT: Not Given


Old work map shows 1/2" bar found 21.3 South and 5.8 feet East of true position

B. Description of corner evidence found and/or method applied in restoring or reestablishing corner:

Found 1/2" Bar South and East of true position as called for in Henning survey. Accepted Henning position as the best available evidence of the original corner.

C. Description of monument for corner and accessories established to perpetuate locating the position of the corner:

Mon. - Set Std. Roscommon County Monument
WIT: Nail & Tag NW side 16" B.Oak N57°E 10.42'
Nail & Tag SW side 9" B.Oak N29°W 31.14'
Nail & Tag SW side 4" W.Oak S24°E 8.56'
Nail & Tag S. side 6" B.Oak N86°W 32.27'
Set Carsonite Post 2.15' East

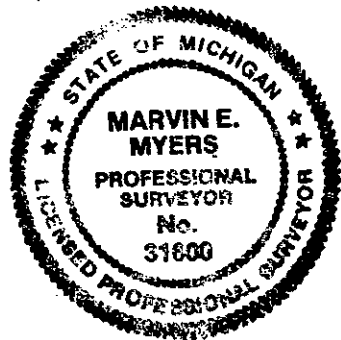

Signed by Marvin E. Myers Date December 27, 1993

Surveyor's Michigan License No. 31600

Date December 14, 1993 Peer Group Approved