

ROSCOMMON COUNTY REMONUMENTATION

9224

FEB 18 1994

LAND CORNER RECORDATION CERTIFICATE
Filing Requirement of Act 74, Mich. P.A. 1970

Dec 28 10 27 AM '93

For corners COMMISSION

Robert J. Myers
REGISTERED SURVEYOR

Roscommon (County)	Located In:	Corner Code #
1. Public Land Survey	T 24N R 4W	M - 10
	T _____ R _____	_____
	T _____ R _____	_____
	T _____ R _____	_____
2. Property Controlling in Section	S _____ T _____ R _____	_____
	S _____ T _____ R _____	_____
3. Miscellaneous Property in Sec.	S _____ T _____ R _____	_____
	S _____ T _____ R _____	_____

**ROSCOMMON COUNTY
PEER GROUP APPROVAL
DATE 12-7-1993**

Register of Deeds Stamp & File Number

4. Lot No. _____, Recorded Plat _____
5. Private Claims _____

	A	B	C	D	E	F	G	H	I	J	K	L	M
2	6	5	4	3	2	1							
3													
4	7	8	9	10	11	12							
5													
6	18	17	16	15	14	13							
7													
8	19	20	21	22	23	24							
9													
10	30	29	28	27	26	25							
11													
12	31	32	33	34	35	36							
13													

I, Marvin E. Myers, in a field survey on Dec 6, 19 93, do hereby certify that under requirements of P.A. 74, Michigan P.A. of 1970, the corner points mentioned in lines 1 and 2 above were in conformance with regulations and rules therefore as required in the current manual of survey instructions of the United States Department of the Interior, Bureau of Land Management or by a decree of a Court of Law and/or that the corner points mentioned in lines 3, 4 and 5 above were in conformance with the rules of the Michigan Board of Land Surveyors or by a Decree of a Court of Law; established, re-established, monumented, re-monumented, recovered, found as expressed below:

NOTE: Not more than 4 corners, all in the same town and range, may be recorded on this certificate.

A. Description of original monument and accessories and/or subsequent restoration:


GLO - April 1839 J.Brinks Mon. - Post WIT: 14" Y.Pine S28½°W 33 lks. 12" Y.Pine N66°E 63 lks.	L.289, pg.676 April 1974 C.Ostling Mon. - WIT: ½" Iron Bar S45°07'W 47.11' 6" B.Oak Stump N37°E 53.00'
Reg. of Deeds Mon. - ½" Bar WIT: 6" B.Oak Stump N37°E 53.00' ½" Bar S45°W 47.11'	L.1, pg.149 LCRC Feb. 1980 F.Arleth Mon. - ½" Bar WIT: 6" B.Oak Stump N37°E 53.00' ½" Bar S45°07'E 47.11'

B. Description of corner evidence found and/or method applied in restoring or reestablishing corner:

Found ½"x30" bar lying on surface verified location by measurement to accessories and corners of record and accepted as the best available evidence of the position of the Original Corner.

C. Description of monument for corner and accessories established to perpetuate locating the position of the corner:

Mon- Set 2"x21" Std. Roscommon County Monument.
Wit- Std Nail & tag in W. side of Utility Pole N23°E 150.33
Std. nail & tag in SE side of 5" R. Oak S66°W 64.28
Std. nail & tag in W. side of 2" R. Oak N16°W 17.71
Found ½" bar and cap # 12026 S53°W 47.11
Center o overhead utility line East 36±

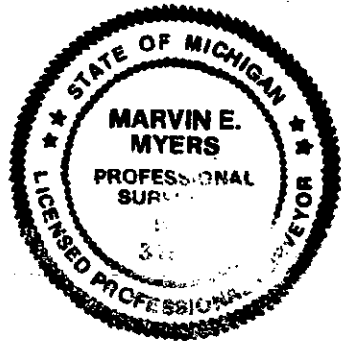

Signed by *Marvin E. Myers*

Date Dec 18, 1993

Surveyor's Michigan License No. 31600

Date Dec 7, 1993

Peer Group Approved