

RECORDED/FILED

APPROVED BY PEER GROUP
P.A. 345 OF 1990
SAGINAW COUNTY

1999 REMONUMENTATION PROGRAM
LAND CORNER RECORDATION CERTIFICATE
Filing Requirement of Act 74, Mich. P.A. 1970

1999 SEP 30 A 8:09

MILDRED M. DODAK
REGISTER OF DEEDS
SAGINAW COUNTY, MI.

For corners in

Saginaw Located In: Chapin Twp. Corner Code #
(County)

LIBER 2144 PAGE 1441

Lib 8 Page 63

Register of Deeds Stamp & File Number

- 1. Public Land Survey T 9N R 1E E-11
 T R
- 2. Property Controlling S T R _____
 in Section S T R _____
- 3. Miscellaneous S T R _____
 Property in Sec. S T R _____

- 4. Lot No. _____, Recorded Plat _____
- 5. Private Claims _____

I, John H. Rauser, P.S., in a field survey on September 27, 1999, do hereby certify that under requirements of P.A. 74, Michigan P.A. of 1970, the corner points mentioned in lines 1 and 2 above were in conformance with regulations and rules therefore as required in the current manual of survey instructions of the United States Department of the Interior, Bureau of Land Management or by a decree of a Court of Law and/or that the corner points mentioned in lines 3, 4 and 5 above were in conformance with the rules of the Michigan Board of Land Surveyors or by a Decree of a Court of Law; established, re-established, monumented, re-monumented, recovered, found as expressed below:

NOTE: Not more than 2 corners, all in the same town and range, may be recorded on this certificate.

	A	B	C	D	E	F	G	H	I	J	K	L	M
1													
2	6	5	4	3	2	1							
3													
4	7	8	9	10	11	12							
5													
6	18	17	16	15	14	13							
7													
8	19	20	21	22	23	24							
9													
10	30	29	28	27	26	25							
11													
12	31	32	33	34	35	36							
13													

A. Description of original monument and accessories and/or subsequent restoration:

E-11 Standard Corner, Sections 28, 29, 32, & 33, Chapin Township

1831 GLO wood post placed by Robinson Thomas, D.S.
S37E 111ks (7.26') 16" Maple
N84W 131ks (8.58') 18" Maple

1850's Shiawassee Book A & Other Unrecorded Surveys page 17, lists GLO witnesses

No subsequent record of restoration or perpetuation.

B. Description of corner evidence found and/or method applied in restoring or reestablishing corner:

E-11 Standard Corner, Sections 28, 29, 32, & 33, Chapin Township


Found no evidence of the original government accessories. Found road culvert and concrete deck at the position of the corner. Corner apparently destroyed by bridge construction. Re-established the corner at a calculated position on line between F-11 and D-11 using the single proportionate measurement. Corner falls in line with a field occupation to the south. Found no conflicting evidence in the vicinity of this position. We recommend that the calculated position be accepted as the best available evidence of the position of the original government corner and a standard Saginaw County 5/8" re-rod with brass cap placed in a monument box in the approximate center line of Kramer Road.

C. Description of monument for corner and accessories established to perpetuate locating the position of the corner:

E-11 Standard Corner, Sections 28, 29, 32, & 33, Chapin Township

Set 5/8" re-rod with standard Saginaw County brass cap stamped "E-11 39096" in concrete box culvert and monument box.

- S88W 807.86' Found 1/2" re-rod at D-11, T9N-R1E
- N45E 27.77' Set 1/2" re-rod w/flagging at the top of ditch bank
- S50E 28.72' Set 1/2" re-rod w/flagging at the top of ditch bank
- N10W 15.75' Set chiseled "+" on top of North end of 3.5' X 5' elliptical concrete culvert
- S15W 17.14' Set chiseled "+" on top of South end of 3.5' X 5' elliptical concrete culvert

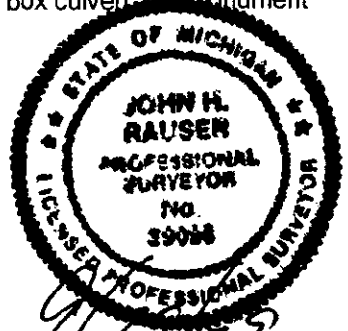

Signed by John H. Rauser
Surveyor's Michigan License No. 39096

Date 9/21/99