

RECORDED/FILED

1999 SEP 30 A 8:09

MILDRED M. DODAK  
REGISTER OF DEEDS  
SAGINAW COUNTY, MI.

LIBER 2144 PAGE 1444

*Lib 8 Page 66*

Register of Deeds Stamp & File Number

APPROVED BY PEER GROUP  
P.A. 345 OF 1990  
SAGINAW COUNTY

1999 REMONUMENTATION PROGRAM  
LAND CORNER RECORDATION CERTIFICATE  
Filing Requirement of Act 74, Mich. P.A. 1970

8-11 *[Signature]*  
For corners in

- Saginaw (County) Located in: Chapin Twp. Corner Code #
- |                                    |   |     |     |      |
|------------------------------------|---|-----|-----|------|
| 1. Public Land Survey              |   | T9N | R1E | G-11 |
|                                    |   | T   | R   |      |
| 2. Property Controlling in Section | S | T   | R   |      |
|                                    | S | T   | R   |      |
| 3. Miscellaneous Property in Sec.  | S | T   | R   |      |
|                                    | S | T   | R   |      |
4. Lot No. \_\_\_\_\_ Recorded Plat \_\_\_\_\_  
5. Private Claims \_\_\_\_\_

|    |   |    |    |    |    |    |    |   |   |   |   |   |   |
|----|---|----|----|----|----|----|----|---|---|---|---|---|---|
| 1  | A | B  | C  | D  | E  | F  | G  | H | I | J | K | L | M |
| 2  |   | 6  | 5  | 4  | 3  | 2  | 1  |   |   |   |   |   |   |
| 3  |   |    |    |    |    |    |    |   |   |   |   |   |   |
| 4  |   | 7  | 8  | 9  | 10 | 11 | 12 |   |   |   |   |   |   |
| 5  |   |    |    |    |    |    |    |   |   |   |   |   |   |
| 6  |   | 18 | 17 | 16 | 15 | 14 | 13 |   |   |   |   |   |   |
| 7  |   |    |    |    |    |    |    |   |   |   |   |   |   |
| 8  |   | 19 | 20 | 21 | 22 | 23 | 24 |   |   |   |   |   |   |
| 9  |   |    |    |    |    |    |    |   |   |   |   |   |   |
| 10 |   | 30 | 29 | 28 | 27 | 26 | 25 |   |   |   |   |   |   |
| 11 |   |    |    |    |    |    |    |   |   |   |   |   |   |
| 12 |   | 31 | 32 | 33 | 34 | 35 | 36 |   |   |   |   |   |   |
| 13 |   |    |    |    |    |    |    |   |   |   |   |   |   |

I, John H. Rauser, P.S., in a field survey on September 27 19 99 do hereby certify that under requirements of P.A. 74, Michigan P.A. of 1970, the corner points mentioned in lines 1 and 2 above were in conformance with regulations and rules therefore as required in the current manual of survey instructions of the United States Department of the Interior, Bureau of Land Management or by a decree of a Court of Law and/or that the corner points mentioned in lines 3, 4 and 5 above were in conformance with the rules of the Michigan Board of Land Surveyors or by a Decree of a Court of Law; established, re-established, monumented, re-monumented, recovered, found as expressed below:

NOTE: Not more than 2 corners, all in the same town and range, may be recorded on this certificate.

A. Description of original monument and accessories and/or subsequent restoration:

G-11 Section Corner, Sections 27, 28, 33, & 34, Chapin Township

1831 GLO wood post placed by Robinson Thomas, D.S.  
N 62W 11lks (7.26') Beech 16"  
S 17 E 30lks (19.8') Beech 8"

1987 ROWE field notes, found no object at corner position, tied fences which are now gone, job cancelled

No subsequent record of restoration or perpetuation

B. Description of corner evidence found and/or method applied in restoring or reestablishing corner:


G-11 Section Corner, Sections 27, 28, 33, & 34, Chapin Township

Found wood stake and stones at the westerly extension of an old fence as determined from field notes (fence is now gone). Found wood stake falls at the approximate intersection of the center lines of Fenmore and Kramer Roads and was approximately 2.5'± below the asphalt grade, in the original soil. This position measured to the adjacent corners as follows: Measured to F-11 as recovered 2657.81; measured to H-11 = 2639.77'; measured to G-12 = 2639.51'; measured to G-10 = 2639.98'. Found stone and crockery at the 1/8 corner North of G-11 measured = 1319.99'. We recommend the position of the found wood stake be accepted as a careful and faithful perpetuation of the position of the original government corner and a standard Saginaw County 5/8" re-rod with brass cap be placed in a monument box.

C. Description of monument for corner and accessories established to perpetuate locating the position of the corner:

G-11 Section Corner, Sections 27, 28, 33, & 34, Chapin Township

Set 5/8" re-rod with standard Saginaw County brass cap stamped "G-11 39096" and monument box  
N50E 43.61' Set PK w/tag #39096 in SE face 5" oak  
S70E 11.93' S. edge S. leg of double arrow "←→" sign post  
N88E 26.87' T/C South end 15" CMP  
S70W 35.38' N. edge stop sign post  
N85W 91.75' T/C telephone riser post  
N80E 10.13' 1/2" re-rod with ROWE traverse cap

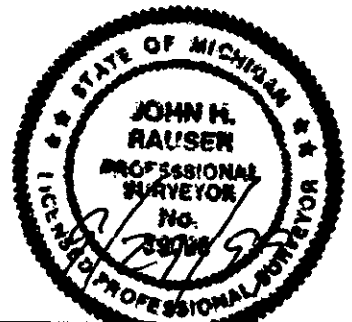

Signed by *John H. Rauser*  
Surveyor's Michigan License No. 39096

Date \_\_\_\_\_