

APPROVED BY PEER GROUP **SECTION 1999 REMONUMENTATION PROGRAM**  
 P.A. 345 OF 1990  
**SAGINAW COUNTY**  
**LAND CORNER RECORDATION CERTIFICATE**  
 Filing Requirement of Act 74, Mich. P.A. 1970

1999 SEP 30 A 8:09

MILDRED M. DODAK  
REGISTER OF DEEDS  
SAGINAW COUNTY, MI.

For corners in

Saginaw (County) Located In: Chapin Twp. Corner Code #

1. Public Land Survey T 9N R 1E J-11  
 T R  
 2. Property Controlling in Section S T R  
 S T R  
 3. Miscellaneous Property in Sec. S T R  
 S T R

4. Lot No. \_\_\_\_\_ Recorded Plat \_\_\_\_\_  
 5. Private Claims \_\_\_\_\_

LIBER 2144 PAGE 1438

*Libers Page 60*

Register of Deeds Stamp & File Number

	A	B	C	D	E	F	G	H	I	J	K	L	M
1													
2	6	5	4	3	2	1							
3													
4	7	8	9	10	11	12							
5													
6	18	17	16	15	14	13							
7													
8	19	20	21	22	23	24							
9													
10	30	29	28	27	26	25							
11													
12	31	32	33	34	35	36							
13													

I, John H. Rauser, P.S., in a field survey on September 17, 1999, do hereby certify that under requirements of P.A. 74, Michigan P.A. of 1970, the corner points mentioned in lines 1 and 2 above were in conformance with regulations and rules therefore as required in the current manual of survey instructions of the United States Department of the Interior, Bureau of Land Management or by a decree of a Court of Law and/or that the corner points mentioned in lines 3, 4 and 5 above were in conformance with the rules of the Michigan Board of Land Surveyors or by a Decree of a Court of Law; established, re-established, monumented, re-monumented, recovered, found as expressed below:

NOTE: Not more than 2 corners, all in the same town and range, may be recorded on this certificate.

A. Description of original monument and accessories and/or subsequent restoration:

J-11 1/4 Corner, Sections 26, & 35, Chapin Township

1831 GLO wood post placed by Robinson Thomas, D.S. at a split distance of 2646.6' (40.10 chains)  
 S34E 12lks (7.92') 18" Elm  
 N21W 32lks (21.12') 14" Elm

1991 Field notes from Spicer Group, set 3/4" solid iron bar on fence line to North, measured East to K-11 = 2710.82' and West to I-11 = 2643.31', measured 1356.5'+ from K-11 west to occupation, doubled = 2713'+

N45W 59.85' Face of 12" hickory  
 North 29.7' Face of 42" maple  
 N70W 67.80' Face of 36" maple

B. Description of corner evidence found and/or method applied in restoring or reestablishing corner:

J-11 1/4 Corner, Sections 26, & 35, Chapin Township


Found no evidence of the original government accessories. Found 3/4" iron bar bent E'ly at top, held where straight, in line with old fence through the center of a 40" Oak to the North and occupation to South. Measured East to J-11 2710.73' (apparent chaining error of 1 chain (66') IE: 2710.73' - 66' = 2644.73'), measured West to I-11 2643.07'. Found no conflicting evidence in the vicinity of this position. We recommend that the found 3/4" iron bar be accepted as the best available evidence of the position of the original government corner and be replaced by a standard Saginaw County 5/8" re-rod with brass cap and placed 0.5' below the gravel surface.

C. Description of monument for corner and accessories established to perpetuate locating the position of the corner:

J-11 1/4 Corner, Sections 26, 27, 34, & 35, Chapin Township

Set 5/8" re-rod with standard Saginaw County brass cap stamped "J-11 1999 39096"

N46E 53.30' Set spike/tag #39096 in NW fc 6" Ash  
 N02E 31.45' Set spike/tag #39096 in E fc 40" Oak  
 N74W 68.84' Set spike/tag #39096 in S fc 21" Oak  
 South 18.08' Set 1/2" rod @ top of ditch bank

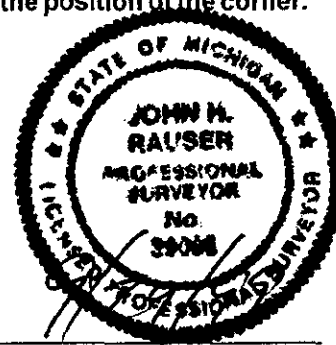

Signed by John H. Rauser

Date \_\_\_\_\_

Surveyor's Michigan License No. 39096