

MAR 12 1999

LIBER 2085 PAGE 1394

SECTION

APPROVED BY PEER GROUP
P.A. 345 OF 1990
SAGINAW COUNTY

1998 REMONUMENTATION PROGRAM
LAND CORNER RECORDATION CERTIFICATE
Filing Requirement of Act 74, Mich. P.A. 1970

Liber 7 Page 253

BDF 8-19-98
for corners in

1998 OCT 13 P 2:09
MILCRED H. DODAK
REGISTER OF DEEDS
SAGINAW COUNTY, MI.

RECORDED/FILED

Register of Deeds Stamp & File Number

Saginaw Located In: Brady Twp. Corner Code # F-13
(County)

- 1. Public Land Survey T 9N R 2E F-13
T _____ R _____
T _____ R _____
T _____ R _____
- 2. Property Controlling S _____ T _____ R _____
in Section S _____ T _____ R _____
- 3. Miscellaneous S _____ T _____ R _____
Property in Sec. S _____ T _____ R _____

- 4. Lot No. _____, Recorded Plat _____
- 5. Private Claims _____

John H. Rauser, P.S., in a field survey on July & August 19 98
do hereby certify that under requirements of P.A. 74, Michigan P.A. of 1970, the corner points mentioned
in lines 1 and 2 above were in conformance with regulations and rules therefore as required in the
current manual of survey instructions of the United States Department of the Interior, Bureau of Land
Management or by a decree of a Court of Law and/or that the corner points mentioned in lines 3, 4 and 5
above were in conformance with the rules of the Michigan Board of Land Surveyors or by a Decree of a
Court of Law; established, re-established, monumented, re-monumented, recovered, found as
expressed below:

NOTE: Not more than 2 corners, all in the same town and range, may be recorded
on this certificate.

	A	B	C	D	E	F	G	H	I	J	K	L	M
1													
2	6	5	4	3	2	1							
3													
4	7	8	9	10	11	12							
5													
6	18	17	16	15	14	13							
7													
8	19	20	21	22	23	24							
9													
10	30	29	28	27	26	25							
11													
12	31	32	33	34	35	36							
13													

A. Description of original monument and accessories and/or subsequent restoration:
F-13 South 1/4 Corner, Section 33, T9N-R2E, Brady Township

- 1824 GLO wood post placed by William Brookfield, D.S.
Elm 16" N65°E 14 links
Maple 16" S52°W 16 links
- 1995 Act 132 by John H. Rauser L.1977, P.1156. Found 3/4" pipe 3'± N of S edge gravel road, bent over & smooth from plow blade, pulled & reset 1/2" x 18" rerod with cap #39096. Four witnesses listed.
- 1995 Act 132 by John H. Rauser L.7, P.411 Shiawassee records; L.1964, P.1081 Saginaw records. Found rerod with cap #39096 as previously set.
- 1996 Field notes from Spicer Engineering Job #S-96-091. Found F-13.

B. Description of corner evidence found and/or method applied in restoring or reestablishing corner:
F-13 South 1/4 Corner, Section 33, T9N-R2E, Brady Township


Found no evidence of original government corner. Found rerod with cap #39096 as per Act 132's above. Found witnesses from same and checked. Measured East to G-13 2628.00 (Spicer 2627.96) measured west to E-13 2603.88 (Spicer 2603.84). Position agrees with the occupied N-S 1/4 line to North. Measured east to occupation south and found 3/4" pipe F-1, T8N-R2E, Shiawassee County 145.24'. Found no conflicting corner or evidence. We accept the position of the rerod with cap #39096 as the best available position of the original government corner.

C. Description of monument for corner and accessories established to perpetuate locating the position of the corner:
F-13 South 1/4 Corner, Section 33, T9N-R2E, Brady Township

Replaced found rerod with 5/8" re-rod and standard Saginaw County brass cap stamped "1998 F-13 39096".

- S02E 18.59' 1/2" rod w/flagging per 1995 Act 132
- S84E 138.15' Set chiseled "+" in T/C S'y end 15" CMP
- N79E 139.92' Set chiseled "+" in T/C N'y end 15" CMP
- N45W 35.54' T/C of W'y end 6" CMP under field entrance

Signed by John H. Rauser
Surveyor's Michigan License No. 39096

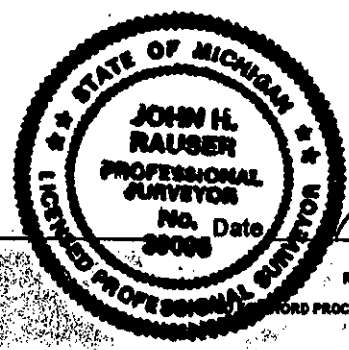

10/07/98