

SURVEY &  
REMONUMENTATION

MAR 12 1999

LIBER 2085 PAGE 1390

SECTION

APPROVED BY PEER GROUP  
P.A. 345 OF 1990  
SAGINAW COUNTY

1998 REMONUMENTATION PROGRAM  
LAND CORNER RECORDATION CERTIFICATE  
Filing Requirement of Act 74, Mich. P.A. 1970

*Page 1 Page 249*

*[Signature]*  
8-9-98  
for corners in

1998 OCT 13 P 2:09  
MILDRED M. DODAK  
REGISTER OF DEEDS  
SAGINAW COUNTY, MI.

RECORDED/FILED

Saginaw Located In: Brady Twp. Corner Code # K-13  
(County)

- |                                    |             |             |             |
|------------------------------------|-------------|-------------|-------------|
| 1. Public Land Survey              | T <u>9N</u> | R <u>2E</u> | <u>K-13</u> |
|                                    | T _____     | R _____     | _____       |
|                                    | T _____     | R _____     | _____       |
|                                    | T _____     | R _____     | _____       |
| 2. Property Controlling in Section | S _____     | T _____     | R _____     |
|                                    | S _____     | T _____     | R _____     |
| 3. Miscellaneous Property in Sec.  | S _____     | T _____     | R _____     |
|                                    | S _____     | T _____     | R _____     |

Register of Deeds Stamp & File Number

4. Lot No. \_\_\_\_\_ Recorded Plat \_\_\_\_\_
5. Private Claims \_\_\_\_\_
- John H. Rauser, P.S. in a field survey on July & August 19 98

	A	B	C	D	E	F	G	H	I	J	K	L	M
1													
2	6		5		4		3		2		1		
3													
4	7		8		9		10		11		12		
5													
6	18		17		16		15		14		13		
7													
8	19		20		21		22		23		24		
9													
10	30		29		28		27		26		25		
11													
12	31		32		33		34		35		36		
13													

I do hereby certify that under requirements of P.A. 74, Michigan P.A. of 1970, the corner points mentioned in lines 1 and 2 above were in conformance with regulations and rules therefore as required in the current manual of survey instructions of the United States Department of the Interior, Bureau of Land Management or by a decree of a Court of Law and/or that the corner points mentioned in lines 3, 4 and 5 above were in conformance with the rules of the Michigan Board of Land Surveyors or by a Decree of a Court of Law, established, re-established, monumented, re-monumented, recovered, found as expressed below:

NOTE: Not more than 2 corners, all in the same town and range, may be recorded on this certificate.

**A. Description of original monument and accessories and/or subsequent restoration:**  
**K-13 Common 1/4 Corner, Sections 35 & 36, T9N-R2E, Brady Township**

- 1824 GLO wood post placed by William Brookfield, D.S. Measured 40 chains (2640') between K-13 & L-13. Measured 40 chains (2640') between K-13 & J-13.  
Elm 16 N53°E 3 links  
Beech 7 S58°W 12 1/2 links
- 1960 Survey shows jog & corners 204.60' apart and listed two witnesses for K-13 south 11.3 to ↔ sign N30E 35' Rd sign.
- 1991 Act 132 by M.L. VanRaemdonck witnessed K-13 L.1796, P.220
- 1994 Act 132 by M.L. VanRaemdonck witnessed K-13 L.1917, P.464

**B. Description of corner evidence found and/or method applied in restoring or reestablishing corner:**  
**K-13 Common 1/4 Corner, Sections 35 & 36, T9N-R2E, Brady Township**


Found 1/2" rod without cap in monument box 1.5'+/- South of centerline of Johnstone Road in approximate centerline of Fordney Road to North. Found ↔ sign from 1960 survey replaced and road sign removed. Found all witnesses from Act 132's listed above. Found no evidence of original government accessories. GLO jog of 310 links (204.6') measured 203.19'. Accepted the position of the 1/2" rod without cap as the best available evidence of the position of the original government corner.

**C. Description of monument for corner and accessories established to perpetuate locating the position of the corner:**  
**K-13 Common 1/4 Corner, Sections 35 & 36, T9N-R2E, Brady Township**

Replaced found 1/2" rod in monument box, with 5/8" rebar and standard Saginaw County brass cap, stamped "1998 K-13 39096"

- North 2' Centerline of Johnstone Road
- N50°E 51.69' Top, center of T. riser leaning NE'ly
- N30°W 39.52' S Fc stop sign post
- South 14.42' N Fc W leg ↔ sign
- West 54' West end of pavement
- West 203.19' K-13 T9N-R2E

Signed by *[Signature]*  
Surveyor's Michigan License No. 39096

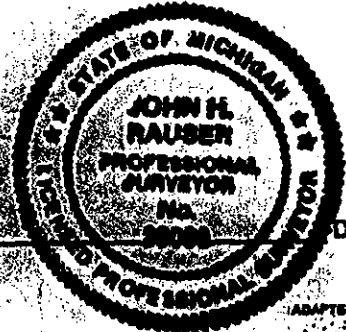

Date *10/07/98*