

BD 9-16-98

LAND CORNER RECORDATION CERTIFICATE
Filing Requirement of Act 74, Mich. P.A. 1970

For corners in

SAGINAW Located in: BRADY TWP Corner Code #
(County)


1. Public Land Survey	T <u>9N</u> R <u>2E</u>	<u>M-13</u>
	T <u>9N</u> R <u>3E</u>	<u>A-13</u> ✓
2. Property Controlling in Section	S <u> </u> T <u> </u> R <u> </u>	<u> </u>
	S <u> </u> T <u> </u> R <u> </u>	<u> </u>
3. Miscellaneous Property in Sec.	S <u> </u> T <u> </u> R <u> </u>	<u> </u>
	S <u> </u> T <u> </u> R <u> </u>	<u> </u>

1998 OCT - 5 A 9: 53
MILDRED M. DODAK
REGISTER OF DEEDS
SAGINAW COUNTY, MI.
RECORDED/FILED
Liber 7 Page 218
Register of Deeds Stamp & File Number

4. Lot No. _____, Recorded Plat _____
5. Private Claims _____

I, Brian D Ferguson, in a field survey on AUGUST 12, 19 98 do hereby state that under requirements of P.A. 74, Michigan P.A. of 1970, the corner points mentioned in lines 1 and 2 above were in conformance with regulations and rules therefore as required in the current manual of survey instructions of the United States Department of the Interior, Bureau of Land Management or by a decree of a Court of Law and/or that the corner points mentioned in lines 3, 4 and 5 above were in conformance with the rules of the Michigan Board of Land Surveyors or by a Decree of a Court of Law; established, re-established, monumented, recovered, found as expressed below:

NOTE: Not more than 2 corners, all in the same town and range, may be recorded on this certificate.

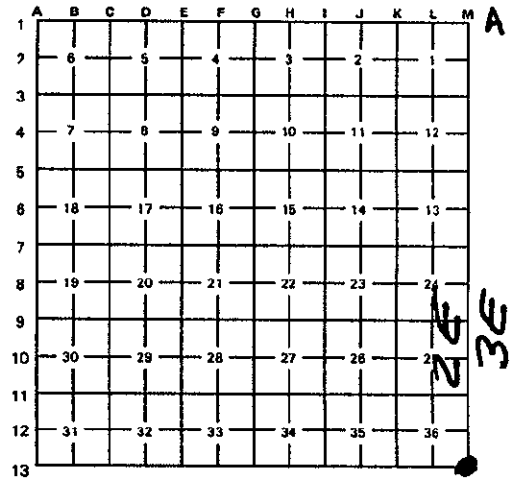

A. Description of original monument and accessories and/or subsequent restoration:

- M-13 WOOD POST SET BY JOHN MULLETT, DEPUTY SURVEYOR, IN 1840
A-13 8" BIRCH S28°W 10 LINKS
12" BIRCH N79°W 23 LINKS
NO EVIDENCE OF ORIGINAL POST REMAINS

SURVEY & REMONUMENTATION

MAR 12 1999

SECTION

B. Description of corner evidence found and/or method applied in restoring or reestablishing corner:

- M-13 FOUND 3/4" PIPE IN MONUMENT BOX
A-13 LCRC BY LEACH ENG IN 1985
SURVEY BY RC ENG IN 1993 & 1995
SURVEY BY SPICER ENG IN 1972
SURVEY BY LEACH ENG IN 1985
THIS IS A COMMON CORNER WITH 4 CONGRESSIONAL TOWNSHIPS

ACCEPTED AS THE BEST AVAILABLE EVIDENCE OF THE POSITION OF THE ORIGINAL CORNER.

C. Description of monument for corner and accessories established to perpetuate locating the position of the corner:

- M-13 SET 5/8" BAR WITH 3" BRASS SAGINAW COUNTY REMONUMENTATION CAP IN EXISTING MONUMENT BOX
A-13 S63°W 42.81' NE COR TELE RISER
S60°E 73.52' FD NAIL NW SIDE GUY POLE
N65°E 69.19' SW COR TELE RISER
N63°E 68.80' FD NAIL & SHINNER S FCE TELE/GUY POLE
N60°W 52.52' S EDGE S LEG OF STOP SIGN

Signed by Brian D Ferguson
Surveyor's Michigan License No. 26454

Date SEPTEMBER 24, 1998

