APPROVED BY PEER GROUP
P.A. 345 OF 1990
SAGINAW COUNTY
9-23-98

SAGINAW COUNTY REMONUMENTATION

LIBER 2084 PAGE 243

LAND CORNER RECORDATION CERTIFICATE

Filing Requirement of Act 74, Mich. P.A. 1970

Liber 7 Page 221

For corners in

SAGINAW (County)

Located in: CHESANING TWP

				Corner Code #
1. Public Land Survey		T 9N	R 3E	D-13
		T	R	
2. Property Controlling	S	T	R	
in Section	S	T	R	
3. Miscellaneous	S	T	R	
Property in Sec.	S	T	R	

RECORDED/FILED
1998 OCT -5 A 9:53
MILDRED M. DODAK
REGISTER OF DEEDS
SAGINAW COUNTY, MI.

Register of Deeds Stamp & File Number

4. Lot No._____, Recorded Plat_____

5. Private Claims_____

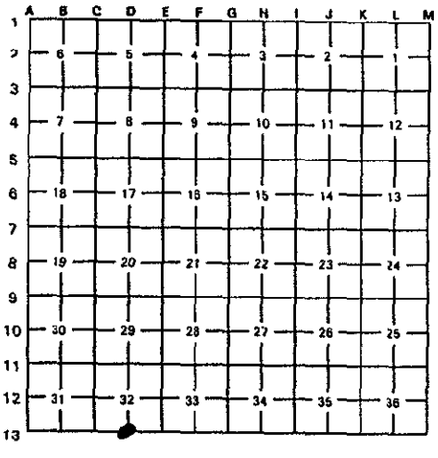

I, Brian D Ferguson, in a field survey on SEPTEMBER 25, 19 98 do hereby state that under requirements of P.A. 74, Michigan P.A. of 1970, the corner points mentioned in lines 1 and 2 above were in conformance with regulations and rules therefore as required in the current manual of survey instructions of the United States Department of the Interior, Bureau of Land Management or by a decree of a Court of Law and/or that the corner points mentioned in lines 3, 4 and 5 above were in conformance with the rules of the Michigan Board of Land Surveyors or by a Decree of a Court of Law; established, re-established, monumented, recovered, found as expressed below:

NOTE: Not more than 2 corners, all in the same town and range, may be recorded on this certificate.

A. *Description of original monument and accessories and/or subsequent restoration:*

D-13 WOOD POST SET BY JOHN MULLETT, DEPUTY SURVEYOR, IN 1840
16" BEECH N32°E 24 LINKS
32" BEECH S79°W 6 1/2 LINKS
LCRC BY VAN RAEMDONCK IN 1980
SURVEY BY VAN RAEMDONCK IN 1980
NO EVIDENCE OF ORIGINAL CORNER REMAINS

B. Description of corner evidence found and/or method applied in restoring or reestablishing corner:

D-13 RE-SET CORNER FROM 1973 SPICER ENGINEERING NOTES GIVING TIES AND ANGLES TO C-12, C-13 AND E-13
FOUND NOTHING FROM RECORDED LCRC. CORNER GONE, ALL WITNESSES GONE.

ACCEPTED AS THE BEST AVAILABLE EVIDENCE OF THE POSITION OF THE ORIGINAL CORNER.

C. Description of monument for corner and accessories established to perpetuate locating the position of the corner:

D-13 SET 5/8" STEEL BAR WITH 3" BRASS SAGINAW COUNTY REMONUMENTATION CAP IN MONUMENT BOX
NORTH 32.87' SET NAIL & SHINER IN W FACE 4"X4" POST
S38°E 17.24' SET 1/2" ROD W/CAP 26454
S52°W 18.39' SET 1/2 ROD W/CAP 26454
N72°W 91.94' SET NAIL & SHINER IN S FACE MAIL BOX POST

STATE OF MICHIGAN
BRIAN D FERGUSON
LAND SURVEYOR
NO. 26454
PROFESSIONAL SURVEYOR

Signed by Brian D Ferguson Date SEPTEMBER 28, 1998

Surveyor's Michigan License No. 26454

FORM APPROVED BY MICHIGAN STATE BOARD OF PROFESSIONAL SURVEYORS, JAN. 28, 1971
REVISED MAY 14, 1975
REVISED JAN., 1983
REVISED OCT., 1995