

APPROVED BY PEER GROUP
P.A. 345 OF 1990 SAGINAW COUNTY REMONUMENTATION PROJECT
SAGINAW COUNTY LAND CORNER RECORDATION CERTIFICATE
Filing Requirement of Act 74, Mich. P.A. 1970

Liber 7 Page 10

For corners in
Saginaw
 (County)
 Chesaning Township

Located In: _____ Corner Code # _____

1. Public Land Survey	T	9N	R	3E	E-4
	T		R		
	T		R		
	T		R		
2. Property Controlling in Section	S		T	R	
	S		T	R	
3. Miscellaneous Property in Sec.	S		T	R	
	S		T	R	

RECORDED & FILED
 SEP 27 9 16 PM '96
 MILDRED M. DODAK
 REGISTER OF DEEDS
 SAGINAW COUNTY MICH.

Register of Deeds Stamp & File Number

4. Lot No. _____ Recorded Plat _____
 5. Private Claims _____

	A	B	C	D	E	F	G	H	I	J	K	L	M
1													
2	6	5	4	3	2	1							
3													
4	7	8	9	10	11	12							
5													
6	18	17	16	15	14	13							
7													
8	19	20	21	22	23	24							
9													
10	30	29	28	27	26	25							
11													
12	31	32	33	34	35	36							
13													

I, John H. Rauser, in a field survey on February 13 19 96, do hereby certify that under requirements of P.A. 74, Michigan P.A. of 1970, the corner points mentioned in lines 1 and 2 above were in conformance with regulations and rules therefore as required in the current manual of survey instructions of the United States Department of the Interior, Bureau of Land Management or by a decree of a Court of Law and/or that the corner points mentioned in lines 3, 4 and 5 above were in conformance with the rules of the Michigan Board of Land Surveyors or by a Decree of a Court of Law; established, re-established, monumented, re-monumented, recovered, found as expressed below:

NOTE: Not more than 4 corners, all in the same town and range, may be recorded on this certificate.

A. Description of original monument and accessories and/or subsequent restoration:

E-4 Sec. Cor., Sec. 8 & 9, T9N-R3E
 1822 Wood post placed by J. Wampler P.S.
 Beech 10" N67°W, 19 lks (12.54')
 Beech 12" S41 1/2°E, 15 lks (9.90')
 No Date, County Survey Record Pg. 18 Corner References
 Beech 10" S72°E, 10 lks (6.6')
 W. Ash 11" N60°W, 26.5 lks 17.5')
 1949 Spicer Engineering field notes. Found 1/4" x 1" iron bar on end 7" below surface
 1.5± N. of fence line east in centerline of tarvia
 1973 Saginaw County Road Commission Records, found 1" iron bar; later placed a monument box
 East 83.15' N&C N. side T/P
 S20°W 24.90' N&C E. side P/P
 West 56.31' N&C N. side 24" Maple
 1992 Spicer Engineering field notes, found 3/4" hex bar in monument box

B. Description of corner evidence found and/or method applied in restoring or reestablishing corner:


E-4 1/4 Cor, Sec 8&9, T9N-R3E
 Found 1" x 23" Hex bar (air drill bit) in monument box in line w/fence E-W & in centerline of asphalt road. Found no evidence of original government corner or County Survey Record. Found existing witnesses from 1949 & 1992 Spicer Engineering field notes, in agreement with record. Found existing witnesses from 1973 SCRC witnesses, 2 of which to be in discrepancy by 1' (Assumed record distances to be measured or recorded incorrectly). Found monument is accepted as the best available evidence of the position of the original corner.

C. Description of monument for corner and accessories established to perpetuate locating the position of the corner:

E-4 1/4 Cor., Sec. 8&9 T9N-R3E
 Set 5/8" re-rod w/"Saginaw County Monument", brass cap stamped P.S. 39096 in existing monument box.
 N40°W 46.57' Found nail & tag 12018 in NE face 36" Oak (Rec.= 45.18' to fce. 18" Oak 1949)
 West 32.98' Found 3/4" pipe
 S25°W 72.14' Set chis "+" N. rim of San. M.H.
 East 83.13' Found nail & tag in N. face P/P

Signed by: John H. Rauser
 Surveyor's Michigan License No. 39096

Date: Sept.

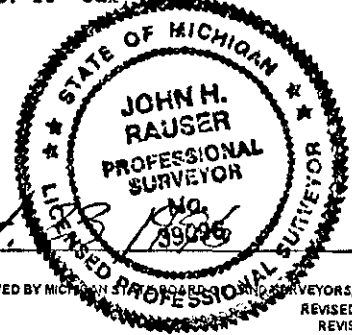

MAY 16 1996