

Lib 7 Page 103

3-13-96 *B.H.R.*
 Filing Requirement of Act 74, Mich. P.A. 1970

For corners in	Located In:	Corner Code #
Saginaw (County)		
Chesaning Township		
1. Public Land Survey	T 9N R 3E	E-5
	T _____ R _____	_____
	T _____ R _____	_____
	T _____ R _____	_____
2. Property Controlling in Section	S _____ T _____ R _____	_____
	S _____ T _____ R _____	_____
3. Miscellaneous Property in Sec.	S _____ T _____ R _____	_____
	S _____ T _____ R _____	_____

MILDRED M. DODAK
 REGISTER OF DEEDS
 SAGINAW COUNTY MICH.
 SEP 27 3 17 PM 1996
 RECORDED & FILED

Register of Deeds Stamp & File Number

4. Lot No. _____, Recorded Plat _____
 5. Private Claims _____

	A	B	C	D	E	F	G	H	I	J	K	L	M
1													
2	6	5	4	3	2	1							
3													
4	7	8	9	10	11	12							
5													
6	18	17	16	15	14	13							
7													
8	19	20	21	22	23	24							
9													
10	30	29	28	27	26	25							
11													
12	31	32	33	34	35	36							
13													

I, John H. Rauser, in a field survey on February 19 96, do hereby certify that under requirements of P.A. 74, Michigan P.A. of 1970, the corner points mentioned in lines 1 and 2 above were in conformance with regulations and rules therefore as required in the current manual of survey instructions of the United States Department of the Interior, Bureau of Land Management or by a decree of a Court of Law and/or that the corner points mentioned in lines 3, 4 and 5 above were in conformance with the rules of the Michigan Board of Land Surveyors or by a Decree of a Court of Law; established, re-established, monumented, re-monumented, recovered, found as expressed below:

NOTE: Not more than 4 corners, all in the same town and range, may be recorded on this certificate.

A. Description of original monument and accessories and/or subsequent restoration:

- E-5 Sec. Cor., Sec. 8, 9, 16 & 17, T9N-R3E
 1822 Wood post placed by J. Wampler, P.S.
 Ironwood 20" N80°E, 8 lks (5.28')
 Ash 9" S26 1/2°W 14 lks (9.24')
 1868 Map of Clarks addition to the Village of Chesaning. I.H Leavenworth, Surveyor
 1949 Spicer Engineering field notes, found 3/4" iron rod
 1976 Unrecorded survey by Odd H. Johnsrud, P.S. #18434
 1977 L.C.R.C. by J.S. Fokens, P.S. #21567, Rec. in L. 4, P. 109, Saginaw County Records
 1977 Act 132 survey by J.S. Fokens, P.S. #21567, Rec. in L. 1557, P. 391, Saginaw County Records
 1990 Act 132 survey by J.S. Fokens, P.S. #21567, Rec. in L. 1802, P. 1478, Saginaw County Records
 1991 L.C.R.C. by J.S. Fokens, P.S. #21567, Rec. in L. 6, P. 77 of corners & L. 1802, P. 1477, Saginaw County Records
 1994 Act 132 survey by J.H. Rauser, P.S. #39096, Rec. in L. 1912, P. 1853, Saginaw County Records


B. Description of corner evidence found and/or method applied in restoring or reestablishing corner:

- E-5 Sec. Cor., Sec. 8, 9, 16 & 17, T9N-R3E
 Found no evidence of original government corner. Found 2" iron pipe over 1" iron bar (apparent axle shaft) 2' below asphalt surface, no monument box. Found 1949 Spicer Engineering field note witnesses in agreement with record. Also found witnesses from J. Fokens in agreement with record. The monument as found is accepted as the best available evidence of the position of the original corner.

C. Description of monument for corner and accessories established to perpetuate locating the position of the corner:

- E-5 Sec. Cor., Sec. 8, 9, 16 & 17, T9N-R3E
 Placed 5/8" re-rod w/"Saginaw County Monument" brass cap, stamped P.S. 39096 and monument box.
 N45°E 100.81' SW Cor. Block Building. (R= 100.90' 1949)
 S40°E 75.40' NW original Block Foundation of House. (R= 75.36' 1949)
 S45°W 61.55' N&T #21567 E. Fce. P/P
 N45°W 37.54' N&T Fce P/P (M-DOT tag)
 S30°E 39.47' N&T W. Fce. P/P

Signed by John H. Rauser Date Sept. 27 1996
 Surveyor's Michigan License No. 39096

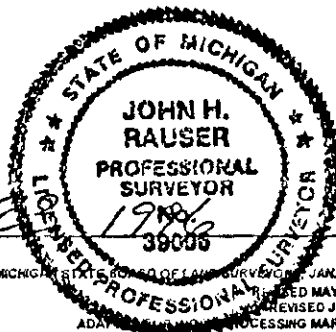

FORM APPROVED BY MICHIGAN BOARD OF LAND SURVEYORS, JAN. 28, 1974
 REVISED MAY 14, 1975
 REVISED JAN. 1983
 ADAPTED FROM PROCESSING MARCH, 1993

MAY 16 1997