

APPROVED BY PEER GROUP
P.A. 345 OF 1990
SAGINAW COUNTY

SAGINAW COUNTY REMONUMENTATION PROJECT

LAND CORNER RECORDATION CERTIFICATE

Filing Requirement of Act 74, Mich. P.A. 1970

Liber 7 Page 10

3-13-96 *[Signature]*

MILDRED H. DODAK
REGISTER OF DEEDS
SAGINAW COUNTY MICH.

SEP 27 3 17 PM '96

RECORDED & FILED

For corners in	Located In:	Corner Code #
Saginaw (County)		
Chesaning Township		
1. Public Land Survey	T 9N R 3E	E-7
	T R	
	T R	
	T R	
	T R	
2. Property Controlling in Section	S T R	
	S T R	
3. Miscellaneous Property in Sec.	S T R	
	S T R	

Register of Deeds Stamp & File Number

- 4. Lot No. _____, Recorded Plat _____
- 5. Private Claims _____

I, John H. Rauser, in a field survey on February 19 96, do hereby certify that under requirements of P.A. 74, Michigan P.A. of 1970, the corner points mentioned in lines 1 and 2 above were in conformance with regulations and rules therefore as required in the current manual of survey instructions of the United States Department of the Interior, Bureau of Land Management or by a decree of a Court of Law and/or that the corner points mentioned in lines 3, 4 and 5 above were in conformance with the rules of the Michigan Board of Land Surveyors or by a Decree of a Court of Law; established, re-established, monumented, re-monumented, recovered, found as expressed below:

NOTE: Not more than 4 corners, all in the same town and range, may be recorded on this certificate.

	A	B	C	D	E	F	G	H	I	J	K	L	M
1													
2	6	5	4	3	2	1							
3													
4	7	8	9	10	11	12							
5													
6	18	17	16	15	14	13							
7													
8	19	20	21	22	23	24							
9													
10	30	29	28	27	26	25							
11													
12	31	32	33	34	35	36							
13													

A. Description of original monument and accessories and/or subsequent restoration:

E-7 Sec. Cor., Sec. 16, 17, 20 & 21, T9N-R4E
 1822 Wood post placed by J. Wampler, D.S.
 Ash 13" S19°W, 8 lks (5.28')
 Elm 12" S40 1/2° 4 lks (2.64')
 1951 Spicer Engineering Field Notes, set 3/4" x 20" iron pipe flush w/tarvia surface
 1972 L.C.R.C. by J.W. Martin, P.S. #4699 Rec. in L. 1, P. 227, Saginaw County Records
 1978 Act 132 survey by J.S. Fokens P.S. #4699 Rec. in L. 1529, P. 61, Saginaw County Records
 1979 L.C.R.C. by J.S. Fokens, P.S. #21567 Rec. in L. 5, P. 54, Saginaw County Records


B. Description of corner evidence found and/or method applied in restoring or reestablishing corner:

E-7 Sec. Corner, Sec. 16, 17, 20 & 21, T9N-R3E
 Found no evidence of original government corner.
 Found 3/4" x 12" pipe w/ unreadable cap over 3/4" x 18" pipe below asphalt surface, no monument box.
 1951 Spicer Eng. witnesses have been destroyed by cross culvert construction.
 Found one remaining 1972 J. Martin witness in agreement with record.
 Found SW 1/8 Cor on S. line Sec. 16 in agreement w/ 1951 Spicer records.
 Measured 1/2 mile east to F-7 2491.62 feet, measure to SW 1/8 Corner 1245.68' (R= 1245.81')
 Found witness from 1979 Fokens in agreement with record.
 The monument as found is accepted as the best available evidence of the position of the original corner.

C. Description of monument for corner and accessories established to perpetuate locating the position of the corner:

E-7 Sec. Cor., Sec. 16, 17, 20 & 21, T9N-R3E
 Placed 5/8" re-rod w/ "Saginaw County Monument"
 Brass cap, stamped P.S. 39096 and monument box.
 S10°W 56.10' Set N&T #39096 E. Fce P/P
 S55°E 38.00' Set chis "+" top center S. end cmp.
 N60°E 59.29' Set chis "+" top center N. end cmp.
 N15°W 38.13' Set N&T #39096 SW Fce 30" Ash
 N45°W 50.56' N&T E. Fce 24" Maple

Signed by John H. Rauser Date Sept. 27 1996
 Surveyor's Michigan License No. 39096

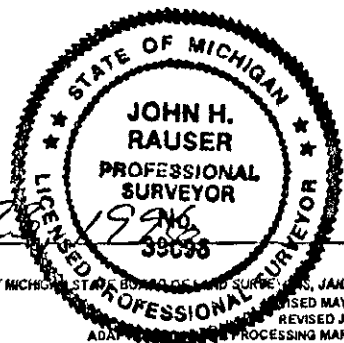

FORM APPROVED BY MICHIGAN BOARD OF LAND SURVEYORS, JAN 28, 1971
 REVISED MAY 14, 1975
 REVISED JAN. 1983
 ADAPTED FROM FORM 1 PROCESSING MARCH, 1993

MAY 18 1997